


DATE 5/29/76

TOWN OF LEXINGTON — BOARD OF PUBLIC WORKS

WATER DIVISION

Sketch of Service Here

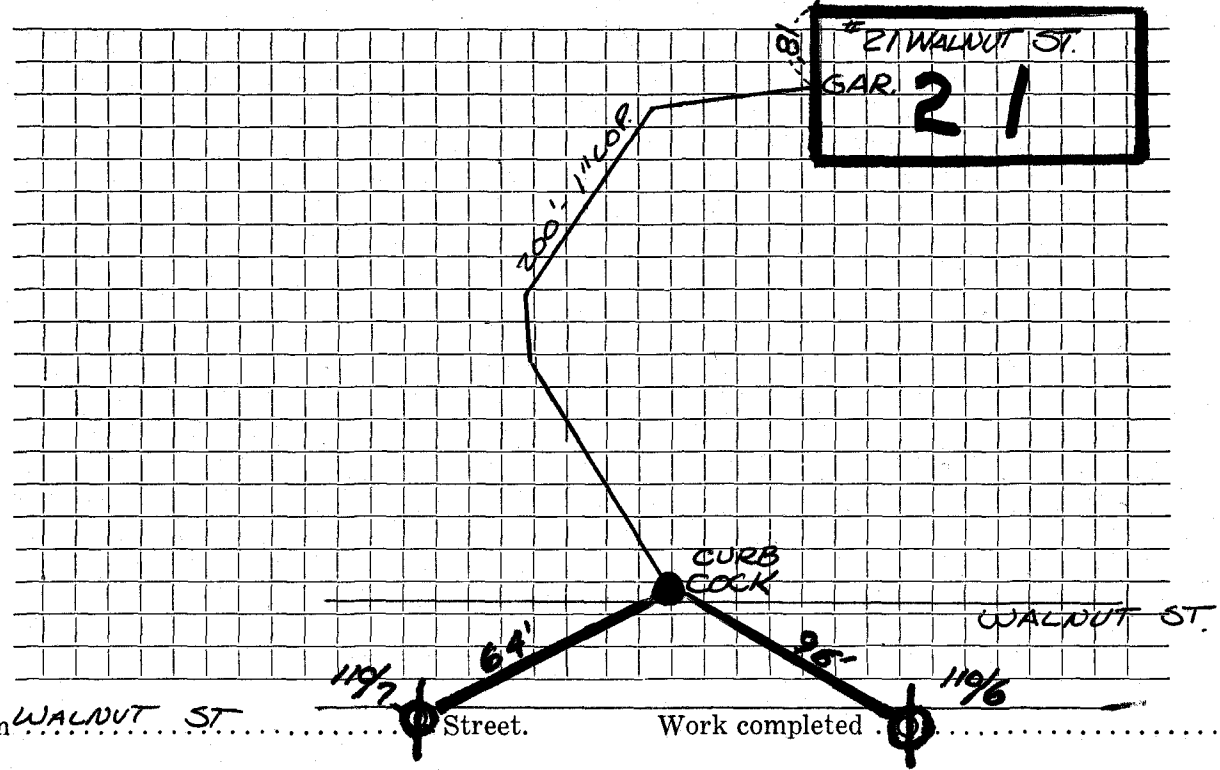

" 21 WALNUT ST.
GAR. 21

Connection made in WALNUT ST Street. Work completed

Remarks: DAVE EAGLE by FDL