

WATER SERVICE RECORD

Name William G. Potter

Service No. 128

Address 34 Walnut Street

Location

~~Repair~~ Renewal - ~~NEW SERVICE~~

Com. 7-18-55

Date	Material	Amount	Total	Date	Amount
5/28/55	Labor	9 25		5-11-55	35 00
	10% overhead	93	10 18	7-18-55	4 82
	21' - 3/4" copper tubing@.3693		7 75		30 18
	1 - 3/4C x 1/8 I.W.H. stop & waste		4 00	5/28/55	14 00
	1 hr. Littlefield shovel		7 50	18' - 3/4" copper tubing@.3693	6 65
	1 hr. trucking		75	1 - 3/4"C. corp-cock	4 33
			30 18	1 - 3/4"C. curb-cock	4 67
				1 box and rod	3 90
				1 - 1/2 offset tail pc.	50
				1 - 1/2 straight tail pc.	50
				2-2/3hrs. Littlefield shovel	7.50-20 00
				1 hr. trucking	75
					55 30


Deposited
Refunded
NON CHARGE

DATE _____

TOWN OF LEXINGTON — BOARD OF PUBLIC WORKS

WATER DIVISION

Sketch of Service Here

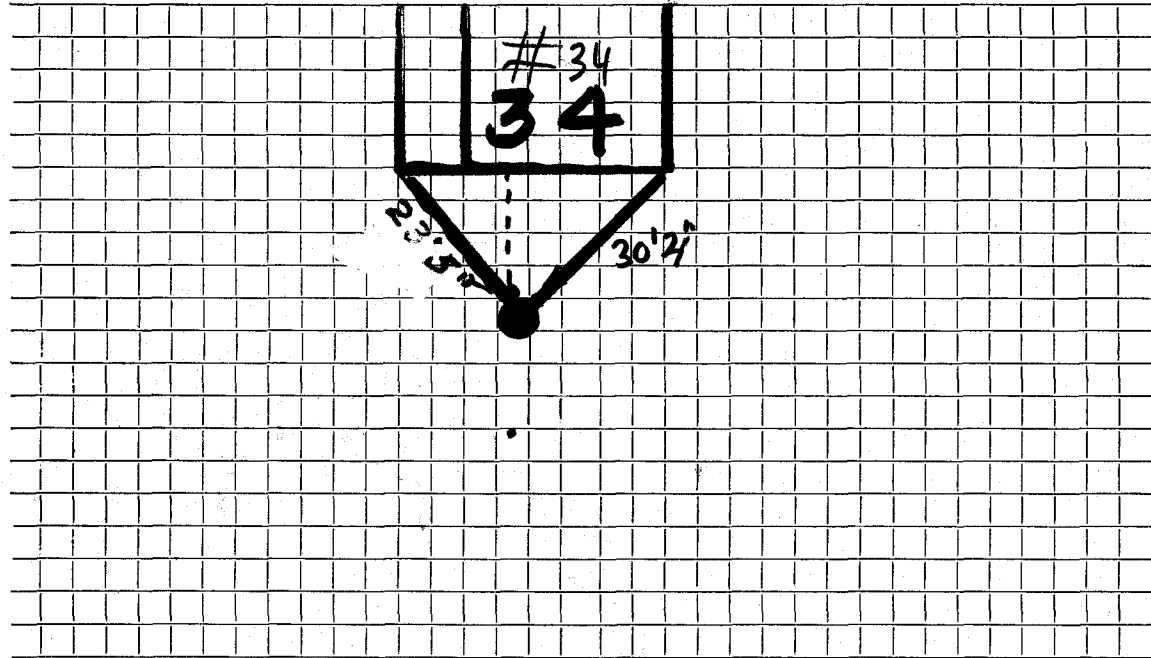

Connection made in Street. Work completed

Remarks:

.....

.....