

Name Middlesex County Sanatorium

Service No. 86

Address Former Shea House - Walnut St  
100-61

Location Former Shea House -

Walnut St.,

Kind of Pipe

Size

Size of Main

~~Repair~~ ~~Renewal~~ New Service

Location

Date  
1940

Material

Amount

Total

Date

Amount

Oct. 1, 1940

54 hrs. @ 60¢

32 40

November 21, 1940 Paid

56 67

Com 11/18/40

10% Overhead

3 24

35 64

78' 1" Copper tubing @ 21¢

16 38

1 1" C x 3/4" I.S. & W.

2 25

1 1" C. Union 3 parts

90

2 hrs. trucking @ 75¢

1 50  
\$56 67

Bill 11/12/40

Labor

DATE \_\_\_\_\_

# TOWN OF LEXINGTON—BOARD OF PUBLIC WORKS

## WATER DIVISION

The undersigned applies for a supply of water at No. 7 Walnut Street and hereby agrees to comply with the rules and regulations as now, or at any future time, established by the Board of Selectmen.

Am't. of Estimate \$ 90.00


Owner  Middlesex County Sanatorium

Am't. Paid \$ \_\_\_\_\_

Address 775 Trapelo Road, Waltham, Mass.

Builder \_\_\_\_\_

By Samuel H. Remick M. D.  
Superintendent

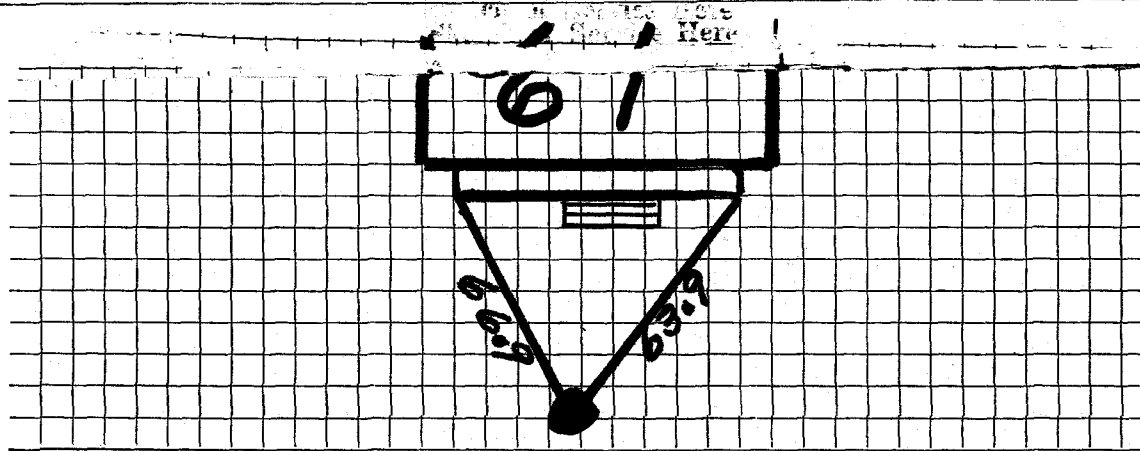

Connection made in \_\_\_\_\_ Street. Work completed \_\_\_\_\_ 19

Remarks: