

WATER SERVICE RECORD

Name

Service No.

Address

7 WALNUT STREET

Location

Repair—Renewal—New Service

RENEWAL


Date	Material	Amount	Total	Date	Amount
8 95	18' of 1" COPPER				
	1-1" x 3/4" REDUCER				
	1-1" CURB STOP				
					Inside
				11-18-'55'	
				45'	3/4" Copper
				1	3/4" C. X 1/2" I.W. H. STOP + Waste

DATE 8/95

TOWN OF LEXINGTON — BOARD OF PUBLIC WORKS

WATER DIVISION

Sketch of Service Here

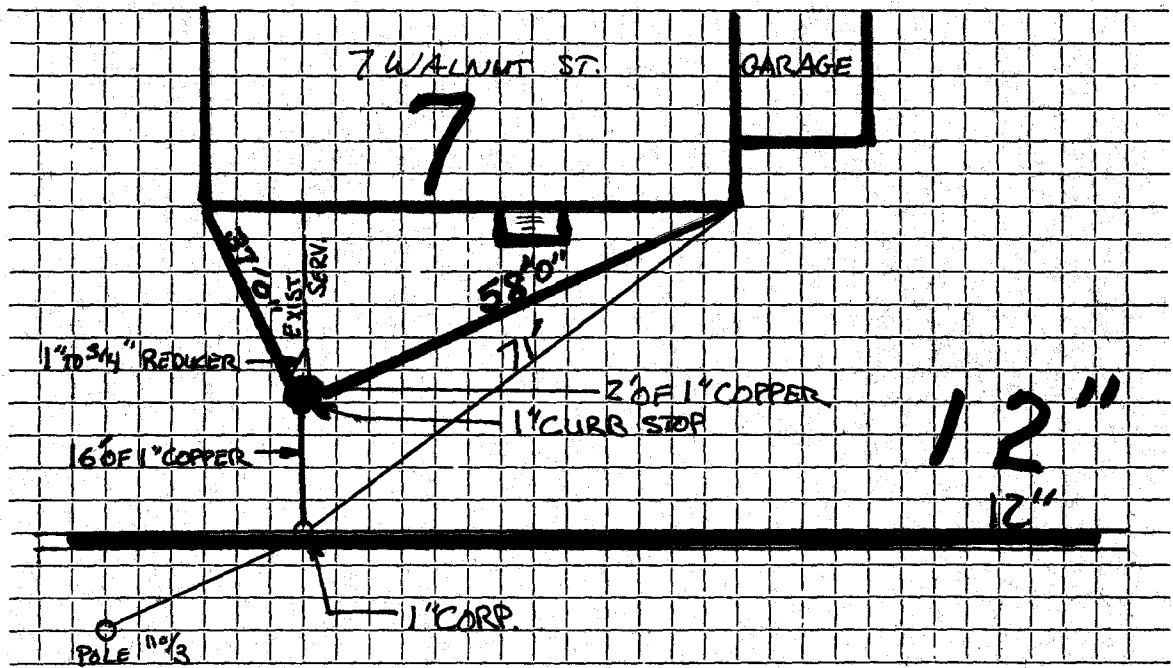

Connection made in Street. Work completed

Remarks:

.....

.....