

Name Salvatore Ricci

Service No. ~~27~~ 2860

Address 1010 Waltham Street,

*Garden Service*

Location Lima's -Waltham Street.

*Across from  
By Brookside Ave?*

Kind of Pipe

Size

Size of Main

Repair—Renewal—New Service

Location

Date  
1939

Material

Amount

Total

Date

Amount

July 14

18 hrs @ 50¢

9 00

21 " @ 60¢

12 60

3 " @ 65¢

1 95

10% Overhead

23 55

2 35

30' 1" Cop. Tubing @ 30¢

9 00

3 1" Corp. Cocks @ 3.75

11 25

1 1" C Adapters

80

2 2" Space Nipples @ 85¢

1 70

1 4-way 2" 1x1" C Branch

7 45

1 2" T.H. Gate Valve

10 50

2' 15" Sewer Pipe @ 60¢

1 20

1 Ford Meter Cover

2 75

2 hrs. Trucking @ 75¢

1 50

72 05

July 10, 1939 Deposited

45 00

Charge Flat Rate: \$45.00

Labor

DATE \_\_\_\_\_

# TOWN OF LEXINGTON—BOARD OF PUBLIC WORKS

## WATER DIVISION

The undersigned applies for a supply of water at No. \_\_\_\_\_ St. and hereby agrees to comply with the rules and regulations as now, or at any future time, established by the Board of Selectmen.

Am't. of Estimate \$ Flu State

~~Owner~~


\_\_\_\_\_

Am't. Paid \$ \_\_\_\_\_

Address \_\_\_\_\_

Builder \_\_\_\_\_

Sketch of Service Here

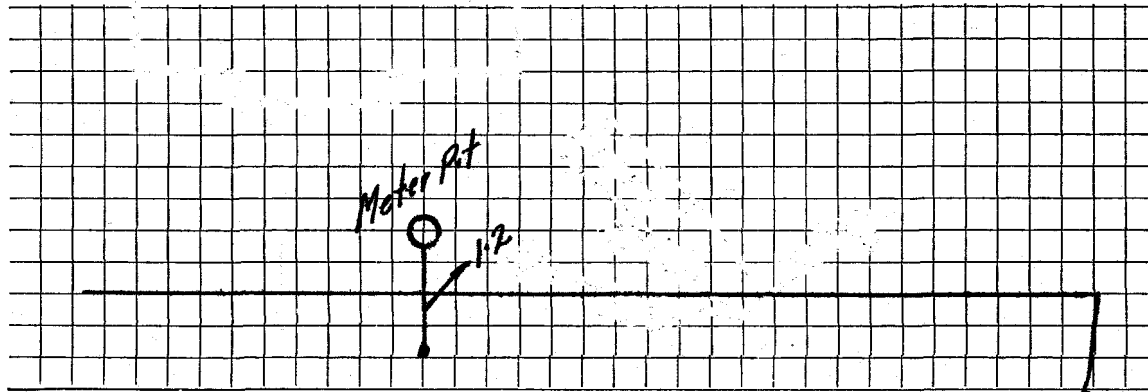

Brookside St

Connection made in \_\_\_\_\_

Street.

Work completed \_\_\_\_\_

19

Remarks: