

WATER SERVICE RECORD

Name

Ricci

Service No.

Address

1012 Waltham Street

Location

PIT

Repair—~~Renewal—New Service~~

Cincotta #4151


Date	Material	Amount	Total	Date	Material	Amount
<i>12/6/82</i>	<i>118' 1½" Copper</i>					
	<i>1 1½" Comp. Union</i>					
	<i>1 Wheel Handle</i>					
	<i>1 Pit</i>					
	<i>1 Frame & Cover</i>					
					<i>OUTSIDE</i>	
				<i>12/6/82</i>	<i>57' 1½" Copper</i>	
					<i>1 6" x 1½" Service Saddle</i>	
					<i>1 1½" Corp.</i>	
					<i>1 1½" Curb</i>	
					<i>1 Curb Box</i>	

DATE _____

TOWN OF LEXINGTON — BOARD OF PUBLIC WORKS

WATER DIVISION

Sketch of Service Here

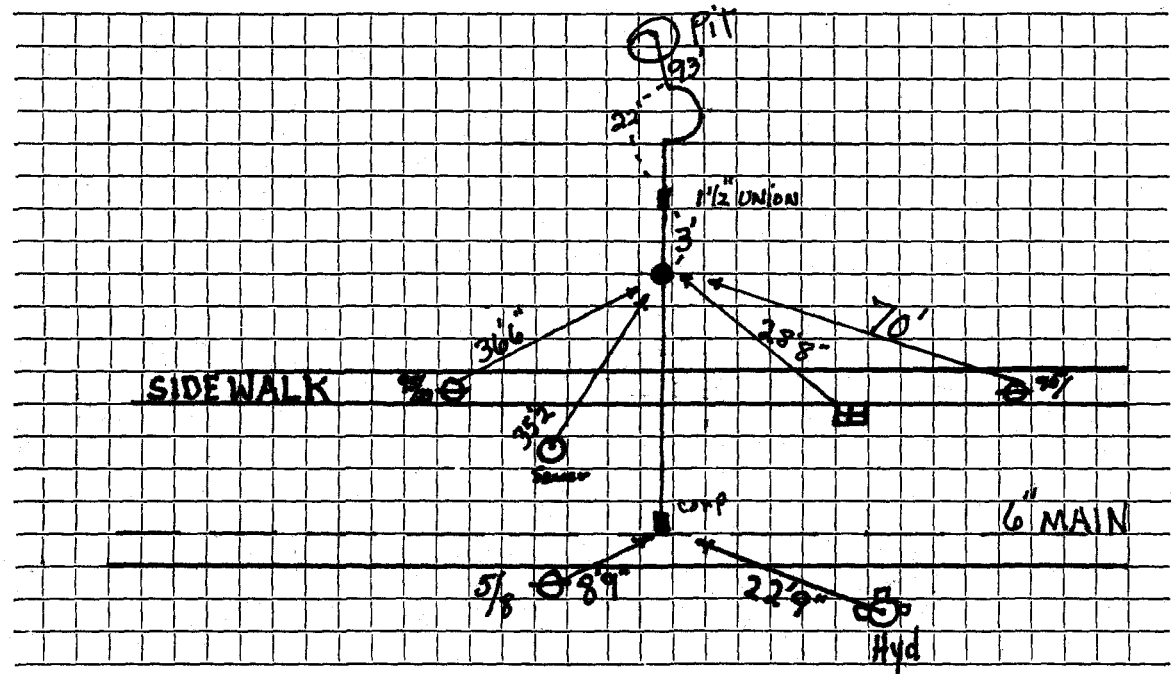

Connection made in Waltham St Street. Work completed

Remarks: 60' Roll Copper in St.

SERVICE SHUT AT CURB 1989 WHEN BROOKHAVEN BUILT