


DATE _____

TOWN OF LEXINGTON — BOARD OF PUBLIC WORKS

WATER DIVISION

Sketch of Service Here

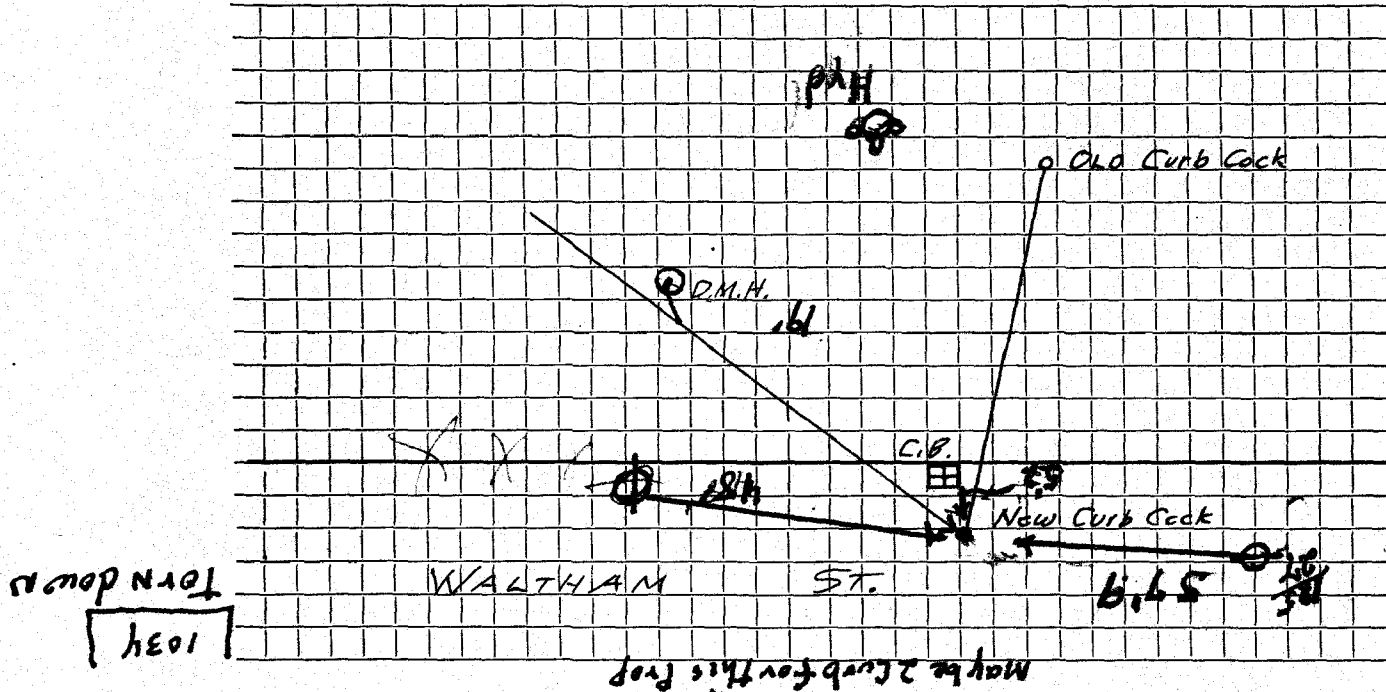

Connection made in Street. Work completed

Remarks:

.....

.....

WATER SERVICE RECORD

Name C. DiMartino & Sons, Inc.

Service No. 68 N.D.

Address 1034 Waltham Street

Location

Repair—~~Remove Old Service~~

Comm 6-19-61

Date	Material	Amount	Total	Date	Amount
5-11-61	Labor	7.08		2-9-62	Paid
	10% O.H.	.71	7.79		58.93
60'	3/4" Copper Tubing @.42		25.20		
2	3/4" Curb Cocks @6.28		12.56		
1	Box & Rod		4.90		
1	1" x 3/4" 3 part union		3.98		
1	1" Style 38 Coupling		3.43		
1	1" Lead Lined Coupling		.54		
1	1" x 3" Cement Lined nipple		.53		
			<u>58.93</u>		


DATE _____

TOWN OF LEXINGTON — BOARD OF PUBLIC WORKS

WATER DIVISION

Sketch of Service Here

New
Build

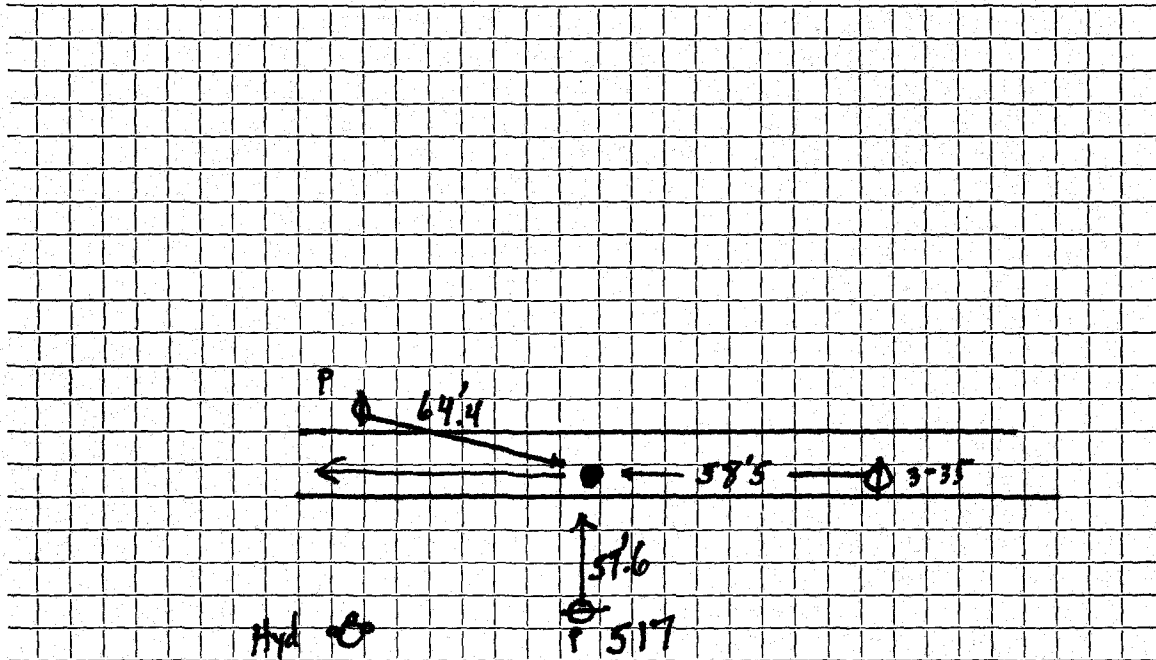

Connection made in Street. Work completed

Remarks: *This shut off may go up the ST. tie into the 1" Service?*
(See other card)