

WATER SERVICE RECORD

Name Haynes Management Inc.

Service No. 22

Address 1040 Waltham Street

Location

~~REWORK~~ - New Service DeFlice #3415 W.O. #728

DEC 3 1979


Date		Material	Amount	Total	Date	Amount
9-27-79	130'	2" Copper tubing			9-6-79	600 00
9-26-79		Labor	217.60			
		10% O.H.	21.76	239.36		506 64
	30'	Orangeburg pipe @.89		26.70		
	6	yds. Gravel @3.25		19.50		
	2	tons Cold Patch @17.20		34.40		
	4	hrs. Trucking @3.00		12.00		
	4	hrs. Backhoe @6.50		26.00		
		Hot Top Street 10' x 14'		93.36		
		Hot Top Street 21' x 3'		42.00		
		Hot Top Sidewalk 4' x 5'		13.32		
				506.64		

DATE _____

TOWN OF LEXINGTON — BOARD OF PUBLIC WORKS

WATER DIVISION

Sketch of Service Here

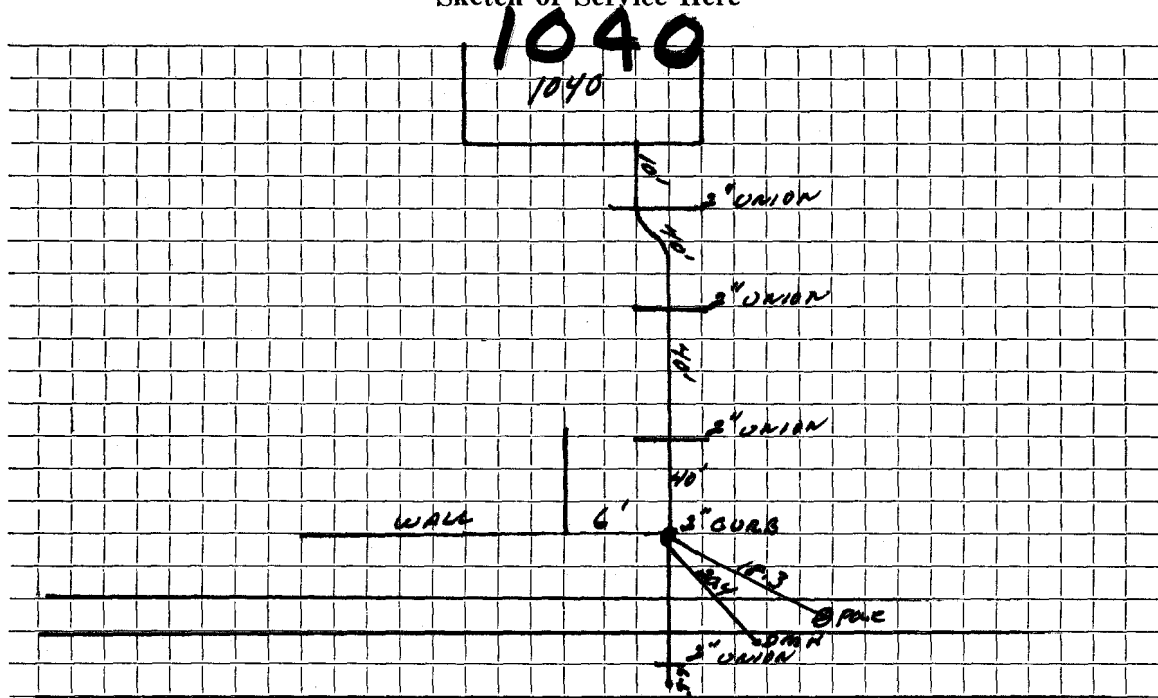

Connection made in Street. Work completed

Remarks:
.....
.....