

WATER SERVICE RECORD

Name G. Arnold Hayes, Inc.

Service No. 6

Address 1050 Waltham Street

Location

~~REPAIRS~~—New Service W.O.596

MAY 29 1973

Date	Material	Amount	Total	Date	Amount
3/30/73	Labor	367 27		3-17-73	Total Cost 895 44
thru 4/5/73	10% O.H.	26 72	403 99	3-13-73	Deposit <u>600 00</u>
	46'-2" Water Pipe @ 2.30		105 80	5-23-73	<i>Paid</i> Balance Due 295 44
	1-2" Curb		49 00		
	1-2" Corporation		32 90		
	1-2" Union		12 00		
	22-ton gravel		41 80		
	1-ton curb patch		6 50		
	1-6"x2" saddle		9 05		
	2-bags insulation		3 60		
	1 curb box		19 00		
	18.8 patching		112 80		
	Trucking @ 3.00		37 50		
	Loader @ 4.00		4 00		
	Compressor @ 5.00		25 00		
	Town Shovel @ 6.50		32 50		
			<u>895 44</u>		


Bill sent 295.44

DATE _____

TOWN OF LEXINGTON — BOARD OF PUBLIC WORKS

WATER DIVISION

Sketch of Service Here

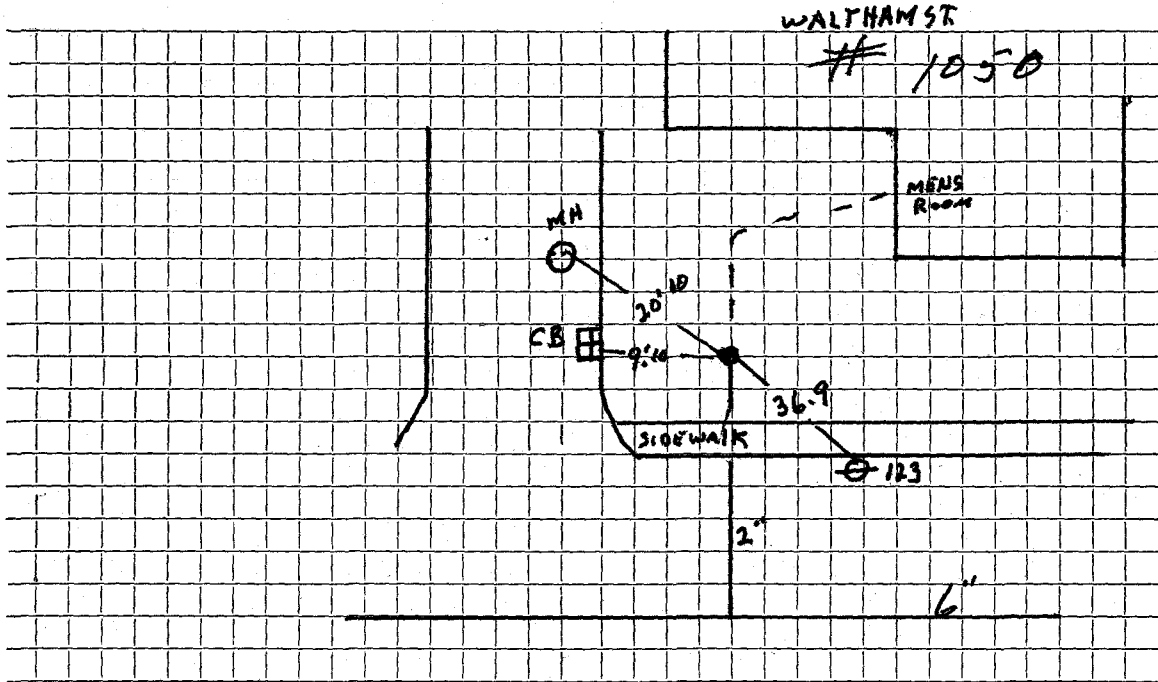

Connection made in Street. Work completed

Remarks:

.....

.....