


DATE _____

TOWN OF LEXINGTON — BOARD OF PUBLIC WORKS
WATER DIVISION

Sketch of Service Here

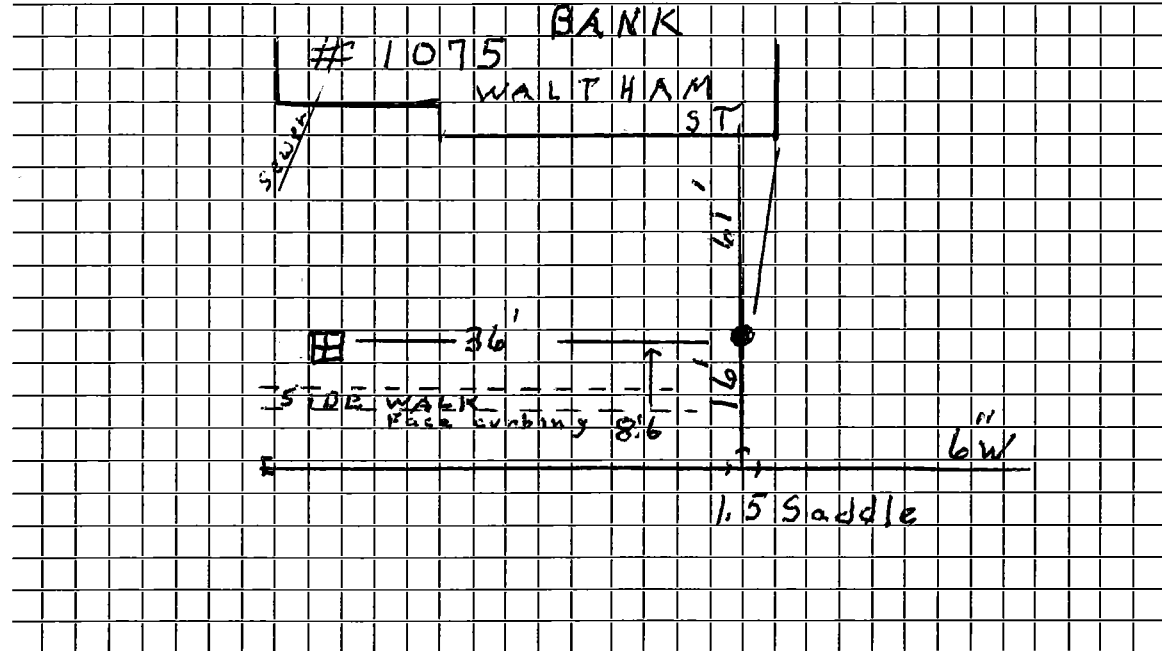

Connection made in Waltham St Street. Work completed 2008

Remarks: Sewer Goes To Waltham

.....
.....