


DATE _____

TOWN OF LEXINGTON — BOARD OF PUBLIC WORKS

WATER DIVISION

Sketch of Service Here

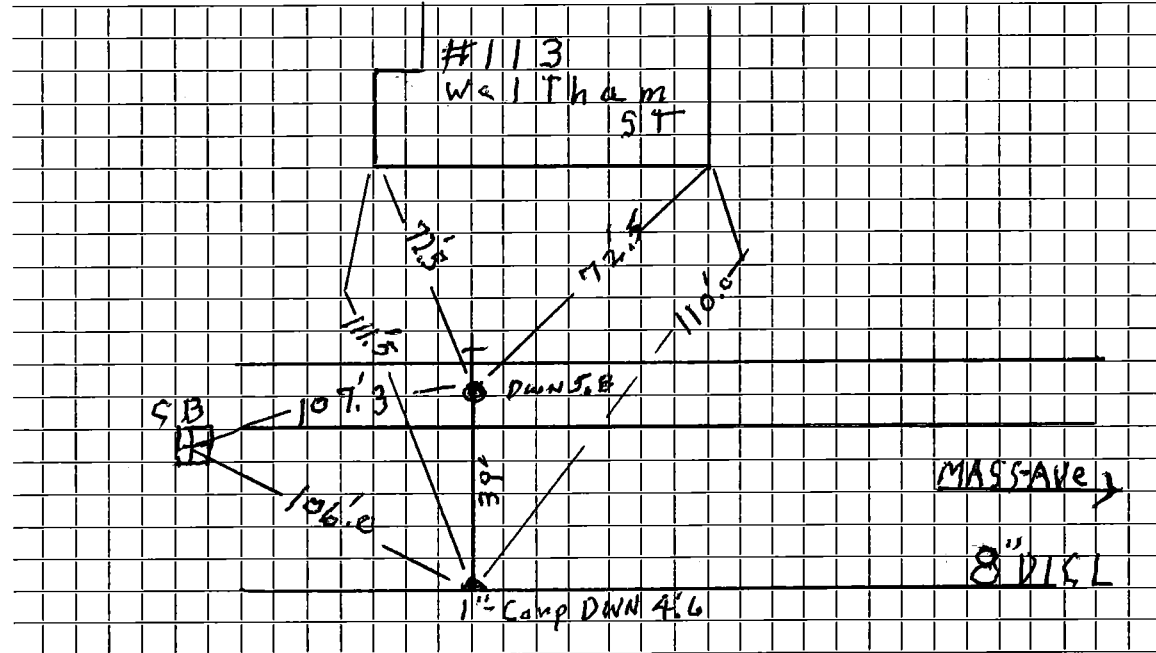

Connection made in Walltham... S.T. Street.

Work completed 8-11-11-Graves

Remarks:

.....

.....