

Name Ethel M. Peterson

Service No. 29 2807

Address 125 Waltham Street

Lexington 73, Mass.

Location 125 Waltham Street

Kind of Pipe

Size

Size of Main

~~Repair~~—Renewal—New Service

Location

Date	Material	Amount	Total	Date	Location	Amount
Nov. 10, '45	Labor	18 31		Nov. 9 '45	<i>Deposited</i>	35 00
	10% Overhead	1 83	20 14	Dec 18 '45		<i>Refunded</i>
	23' - $\frac{3}{4}$ " Copper Tubing		5 64			29 74
	1 - $\frac{3}{4}$ " C x $\frac{3}{4}$ " I.Y Stop & Waste		2 59			
	1 - 1" x $\frac{3}{4}$ " Bushing		33			
	1 - $\frac{3}{4}$ " x $\frac{1}{2}$ " Bushing		29			
	Trucking 1 hr.		75			
			29 74			
	Labor					

Hadley Press, Inc., Lexington

DATE _____

TOWN OF LEXINGTON—BOARD OF PUBLIC WORKS

WATER DIVISION

The undersigned applies for a supply of water at No. _____ St. and hereby agrees to comply with the rules and regulations as now, or at any future time, established by the Board of Selectmen.


Am't. of Estimate \$ _____

Owner _____

Am't. Paid \$ _____

Address _____

Builder _____

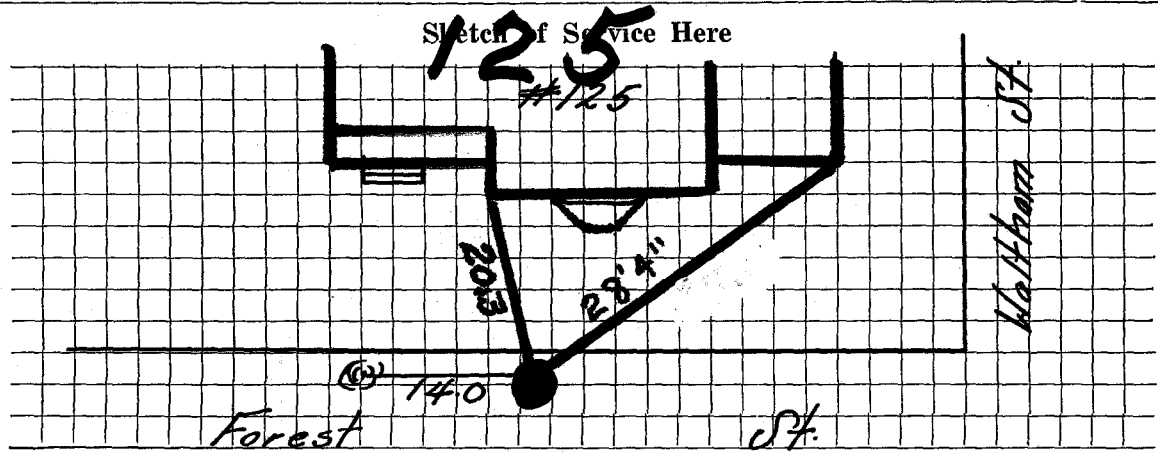

Connection made in _____ Street.

Work completed _____ 19

Remarks: