WATER SERVICE RECORD


Name					Service No.					
Add	lress	150 Waltham Stree	et Build	ing A	Vyne	brook V	/illage			
Location								949 127 184		
Rep	air—R	enewal—New Service W	ambolt Plu	mbing						
Date		Material	Amount	Total		Date			Amount	
5/10/72	61	2" Copper tubing								
					ļ					
	-									
				:						
	-									
	-			-						
	-							<u> </u>		
·	+			-	,					

DATE	 	

TOWN OF LEXINGTON - BOARD OF PUBLIC WORKS

WATER DIVISION

Sketch of Service Here

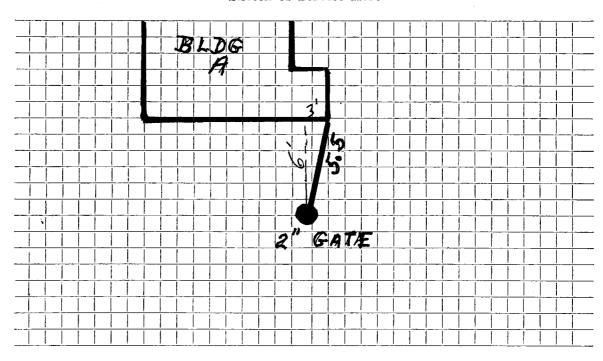

Connection made in Street.	work completed
Remarks:	