WATER SERVICE RECORD


Nar	Name					Service N	Service No.	
Add	lress	150 Waltham Stre	et Build	ding D Vy	nebrook Vi	.llage		
Location						P.49	10/184	
Rep	air—R	enewal—New Service	Wambolt Pl	umbing				
Date		Material	Amount	Total	Date		Amount	
5/10/72	201	2" Copper tubing						
						<u> </u>		

DAT	F
	L

TOWN OF LEXINGTON - BOARD OF PUBLIC WORKS

WATER DIVISION

Sketch of Service Here

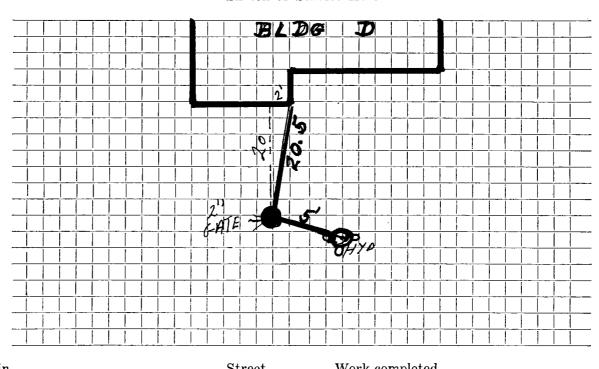

$Connection \ made \ in \ \dots $	Street.	Work completed
Remarks:		
		•••••••••••••••••••••••••••••••••••••••