




TOWN OF LEXINGTON — BOARD OF PUBLIC WORKS

WATER DIVISION

Sketch of Service Here

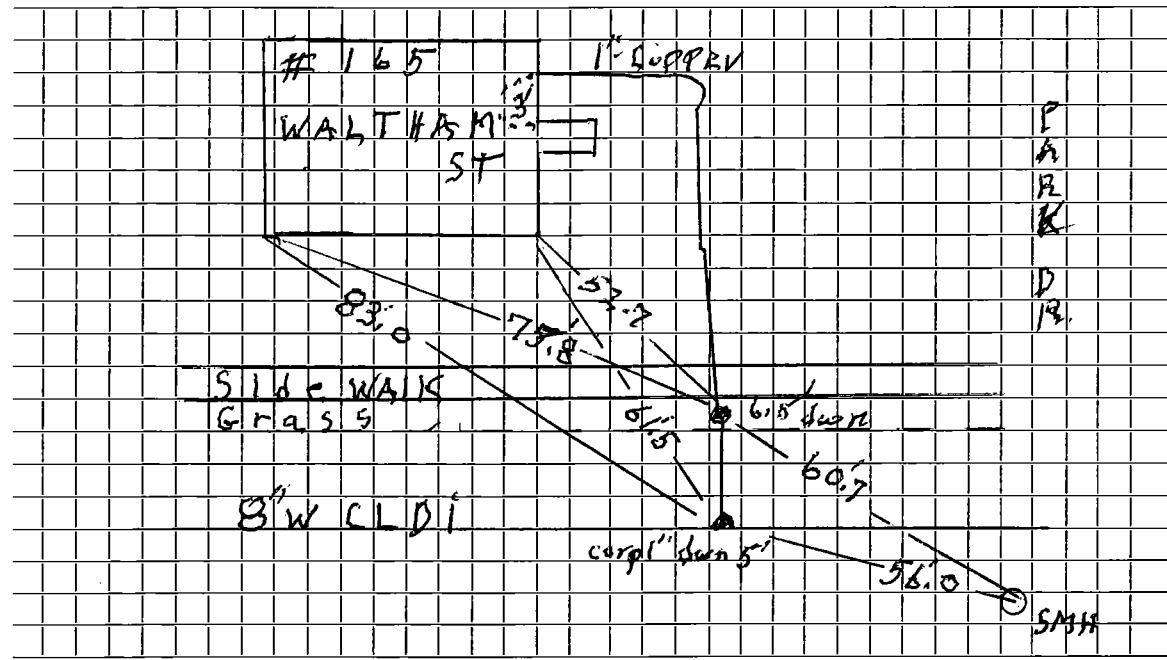

Connection made in WALTHAM ST Street. Work completed 2-13-12 GRASS

Remarks: SEWER IN SAME TRENCH AS WATER

WATER IS 18" ABOVE SEWER TO LEFT OF SEWER