




TOWN OF LEXINGTON — BOARD OF PUBLIC WORKS

WATER DIVISION

Sketch of Service Here

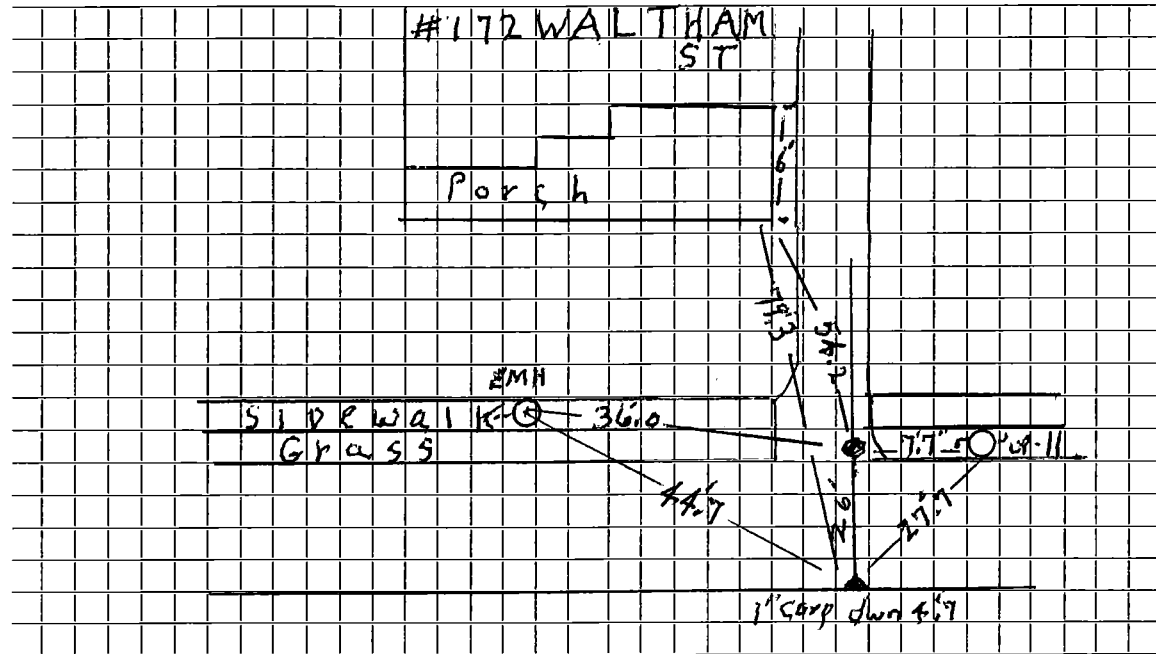

Connection made in... Waltham St ..... Street. Work completed 8-23-12 - Graves .....

Remarks: Old house torn down, New house 1999 .....

.....  
.....