


DATE _____

TOWN OF LEXINGTON — BOARD OF PUBLIC WORKS

WATER DIVISION

Sketch of Service Here

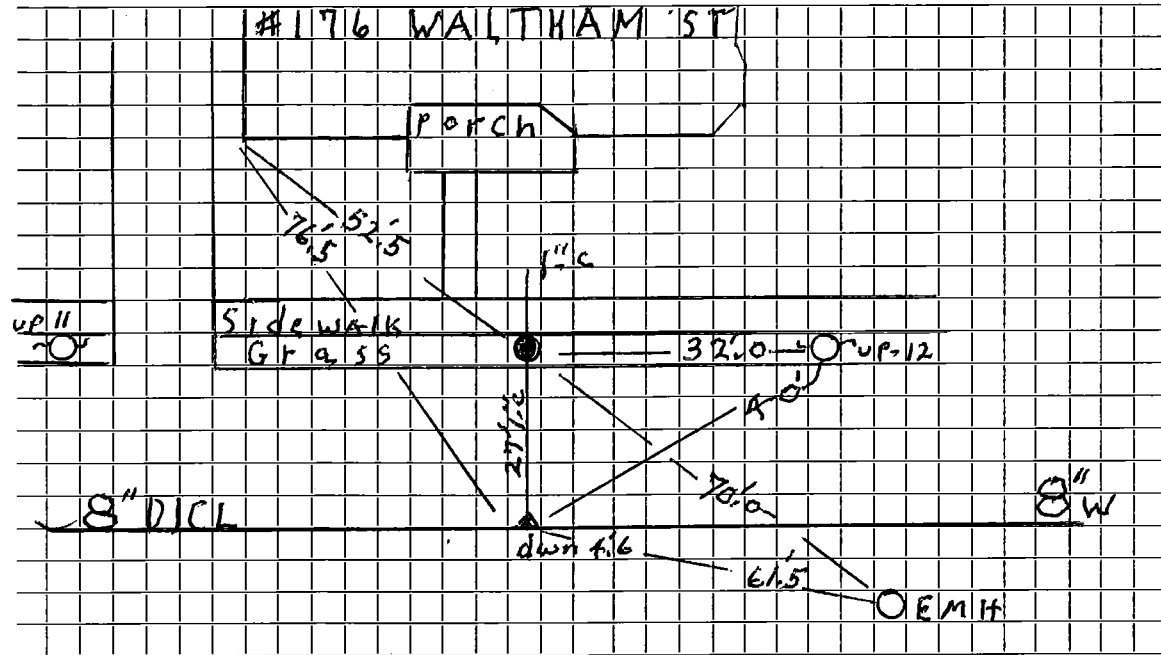

Connection made in Waltham St Street.

Work completed 8-23-12 - Granese

Remarks:

.....

.....