

WATER SERVICE RECORD

Service No.

Name

Address

178 Waltham street

Location

49-20-10T

Repair—Renewal—New Service

Main to Curbstop

8122112 Granese


Date	Material	Amount	Total	Date	Amount
8-22-12	24' 1" Copper				
	1" Corp				
	1" Curb STOP				
	1" x 3/4" Union				
	bufflo box				
EXIST	To house				
1941	42' 3/4" Copper				
	1 3/4" Union - 3 part				
	3/4" SWP				

DATE _____

TOWN OF LEXINGTON — BOARD OF PUBLIC WORKS

WATER DIVISION

Sketch of Service Here

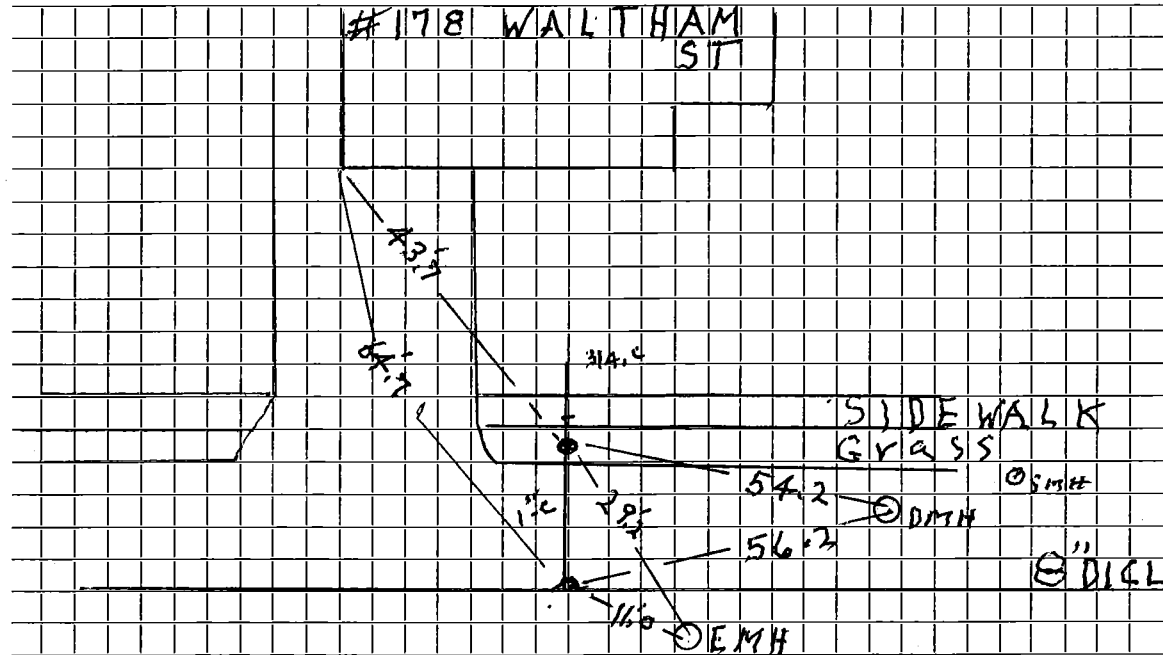

Connection made in Street. Work completed 8-22-12

Remarks:

.....

.....