

Name *Harold Meehan*
 Mr Chas. W. McIntosh

Service No. **# 2811**

Address *182*
~~50~~ Waltham St.

Location

Kind of Pipe

Size

Size of Main

~~Repair~~ - Renewal - ~~NEW SERVICE~~

James McLaughlin #4788

Location

Date	Material	Amount	Total	Date	Amount
P7-29-30 5/18/30 <i>for</i> <i>16.05</i>	40' 1" C.L. Pipe @.27	10 80		<i>July 18 1930 - Cash</i> <i>Checked 1989 COPPER</i>	16 05
	2 1" L.L. Coup. @ .30	60			
	3 1" L.L. Ells @.35	1 05			
	2 1" BR. Sp. Nip. @.30	60			
	1 S & W	3 00	\$16 05		
	Labor on sewer job slip				
<i>7/18/89</i>	<i>inside - Jim McLaughlin</i> <i>51' 2" copper</i>				
	Labor				

Hadley Press, Inc., Lexington

DATE _____

TOWN OF LEXINGTON—BOARD OF PUBLIC WORKS

WATER DIVISION

The undersigned applies for a supply of water at No. _____ St. and hereby agrees to comply with the rules and regulations as now, or at any future time, established by the Board of Selectmen.

Am't. of Estimate \$ _____


Owner _____

Am't. Paid \$ _____

Address _____

Builder _____

Sketch of Service Here

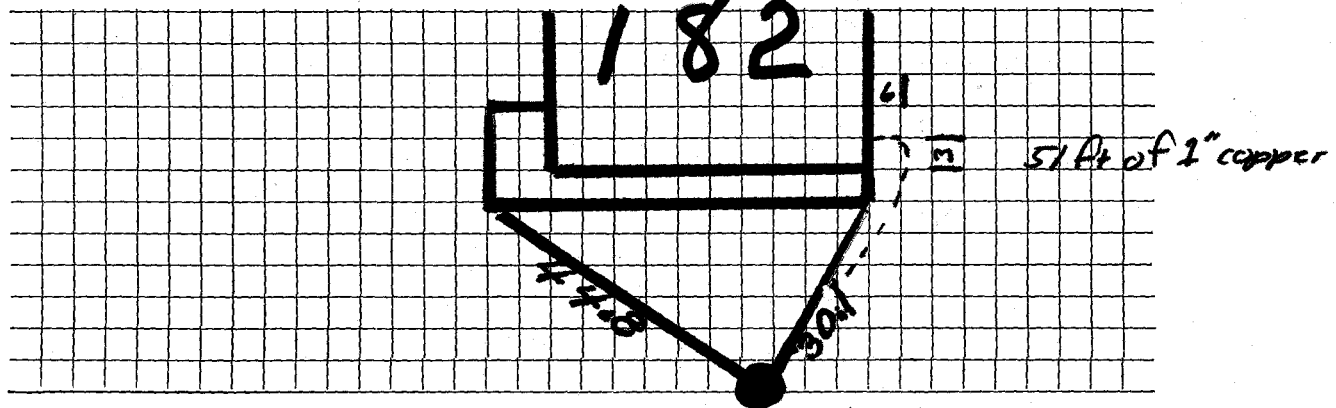

Connection made in _____ Street.

Work completed _____ 19

Remarks: