


DATE _____

TOWN OF LEXINGTON — BOARD OF PUBLIC WORKS

WATER DIVISION

Sketch of Service Here

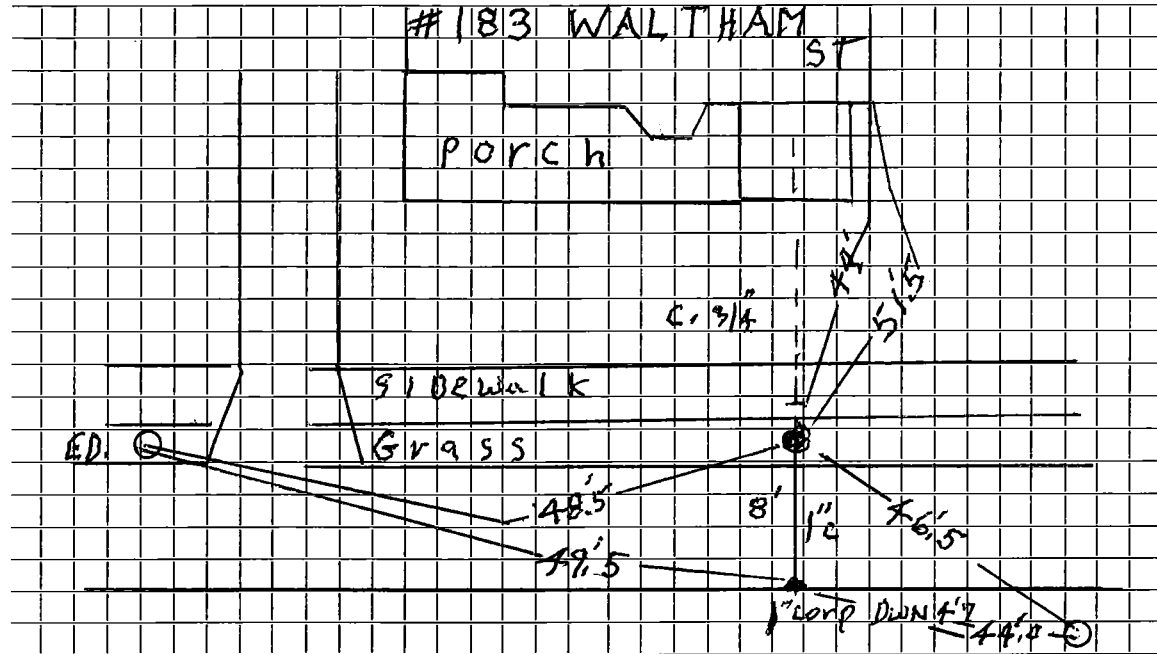

Connection made in Street. Work completed ^{5/14} 0 ^{DMH}

Remarks: 3/4 copper to house ← 8-13-12