




TOWN OF LEXINGTON — BOARD OF PUBLIC WORKS

WATER DIVISION

Sketch of Service Here

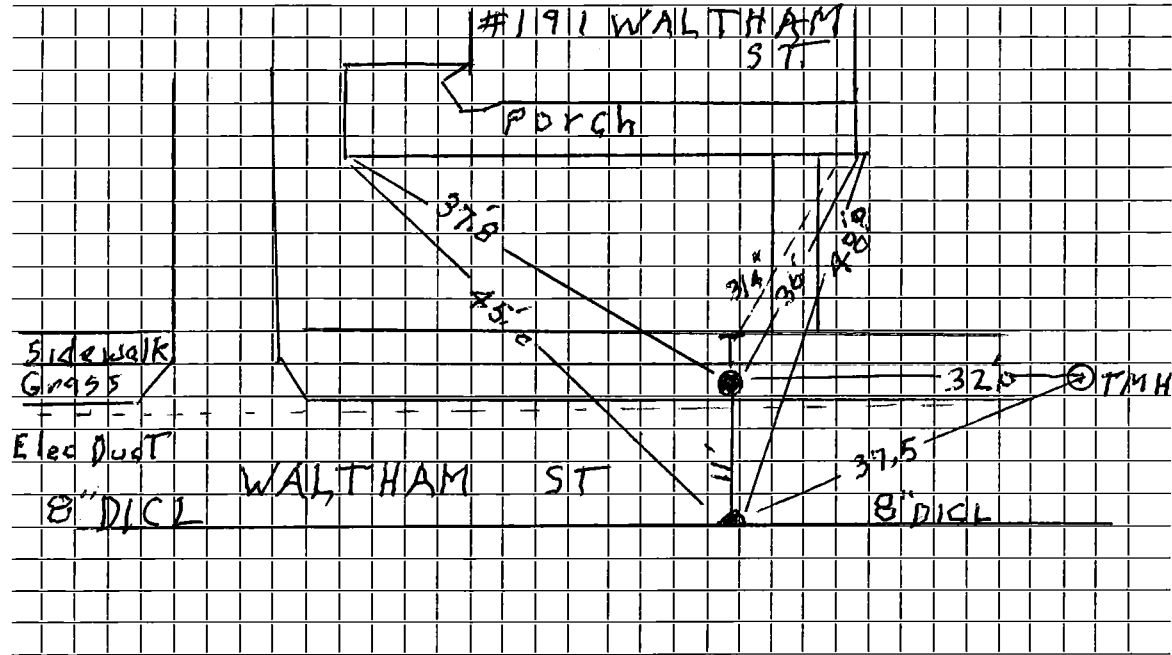

Connection made in..... Street.

Work completed 8-22-12 Granite.....

Remarks:.....

.....

.....