




TOWN OF LEXINGTON — BOARD OF PUBLIC WORKS

WATER DIVISION

Sketch of Service Here

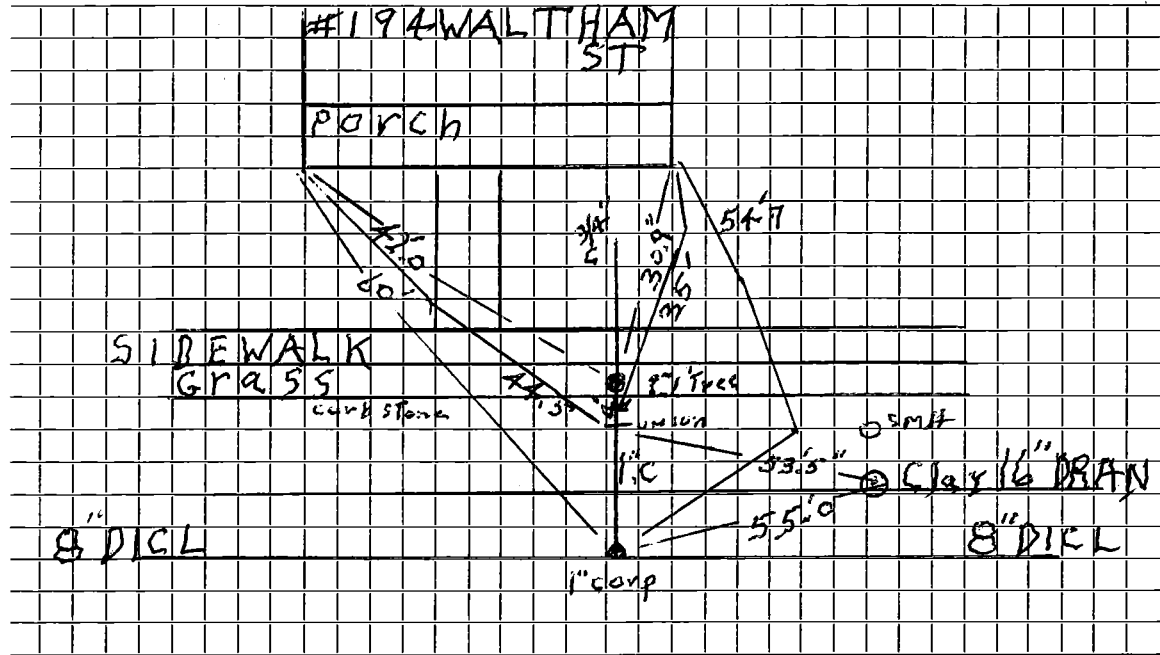

Connection made in... Waltham St ..... Street. Work completed 8-21-12 .....

Remarks: Curb Stop 2' from Edg. rd. beside Tr. & F. From 18.314 Union/Box & Rod .....

.....

.....