

Name Agnes Bongiorno

Service No. 165

Address 197 Wal tham Street

Location

~~Repair~~ - Renewal - ~~New~~ Service

Can 9-29-52


Date	Material	Amount	Total	Date	Amount
8/7/52	Labor	14 20		8-7-52	Deposited 40 00
	10% Overhead	1 42	15 62	9-29-52	Refunded (4 33)
	45' - 3/4" Copper tubing @ .34		15 30		<u>NON CHARGE</u> 25 67
	1 - 3/4" C x 1/2 I.W.H. stop & waste	4 00		8/7/52	Labor 14 20
	1 hr. trucking		75		
			35 67		
					10' - 3/4" Copper tubing @ .34 3 40
					1 - 3/4" C. Adapter 1 95
					1 - 3/4" C x 3/4" C. Curb-cock 4 67
					1 box and rod 3 90
					1 - 1/2 offset tail piece 50
					1 - 1/2 straight tail piece 50
					1 hr. Littlefield shovel 7 00
					1 hr. trucking 75
					patching 6 X 3 6 00
					42 87

DATE _____

TOWN OF LEXINGTON — BOARD OF PUBLIC WORKS

WATER DIVISION

Sketch of Service Here

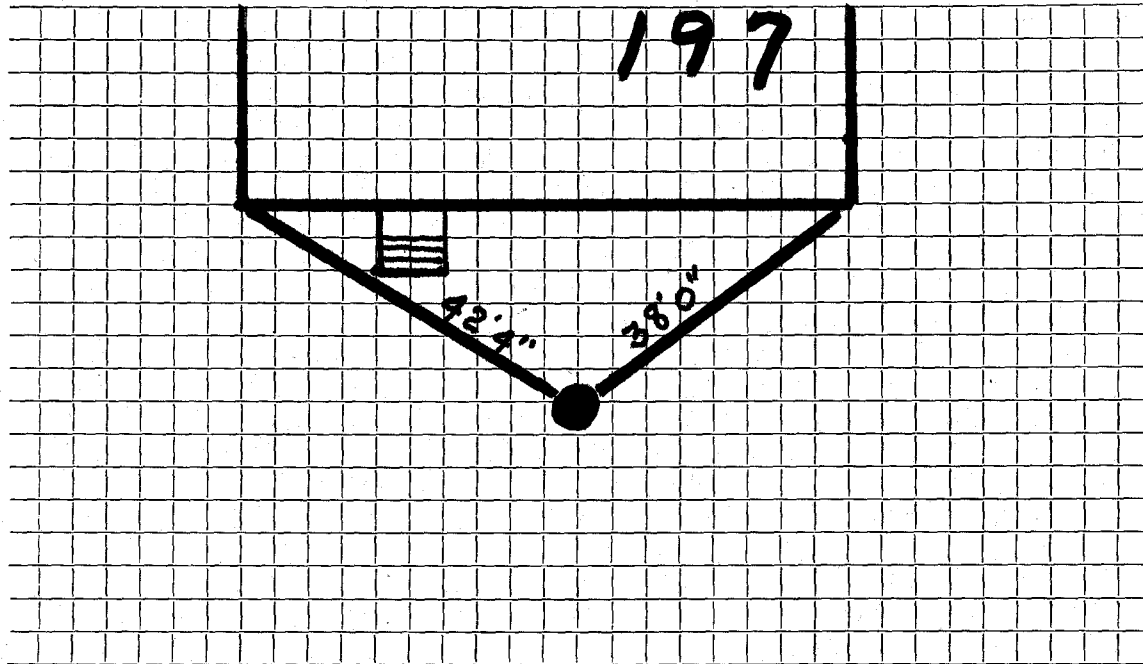

Connection made in Street.

Work completed

Remarks:
.....
.....