


TOWN OF LEXINGTON — BOARD OF PUBLIC WORKS
WATER DIVISION

Sketch of Service Here

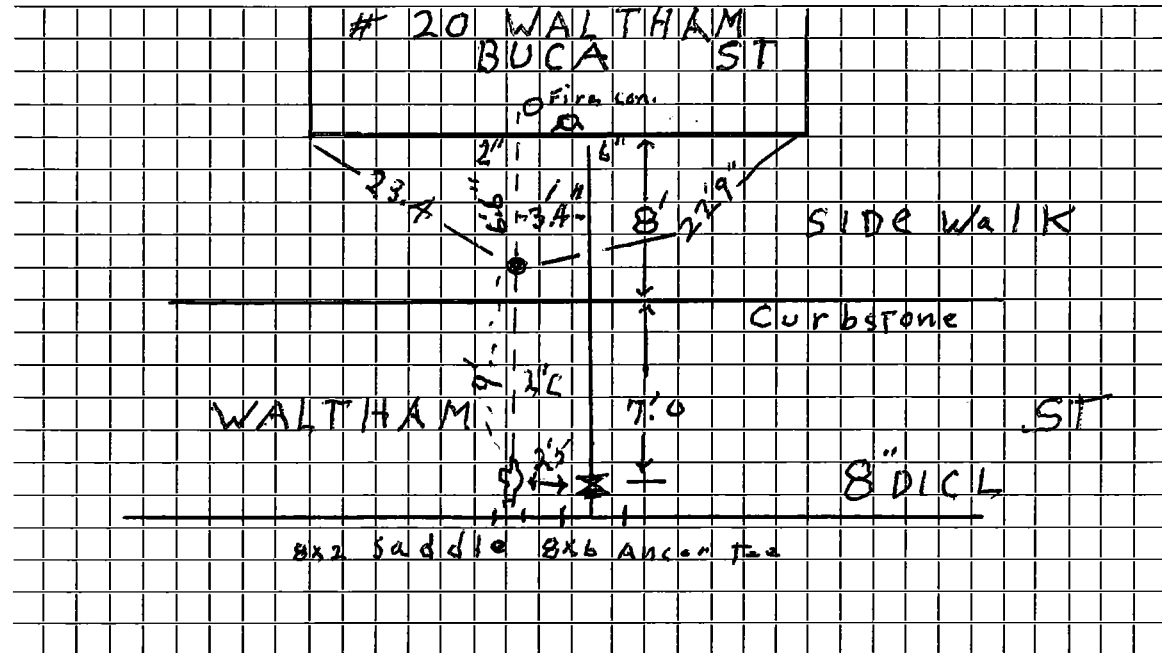

Connection made in Waltham St Street.

Work completed 8/2011 Crane

Remarks: 3' 4" / 2" to 6" W / 6" W To Sewer 16"
2.5' apart