

WATER SERVICE RECORD

Name

Service No.

Address 200 WALTHAM ST.

Location

Repair—Renewal—New Service Artes # 0256


Date	Material	Amount	Total	Date	Amount
6/24/93	63 LF 1" COPPER 2 - 1" UNIONS				
				3-6-80	
				6' 3/4" Copper	
				1' 3/4" Corp Cock	
				1' 3/4" Curb Cock	
				3' 3/4" Copper To 1" Iron inside	

DATE 1/6/93

TOWN OF LEXINGTON — BOARD OF PUBLIC WORKS

WATER DIVISION

Sketch of Service Here

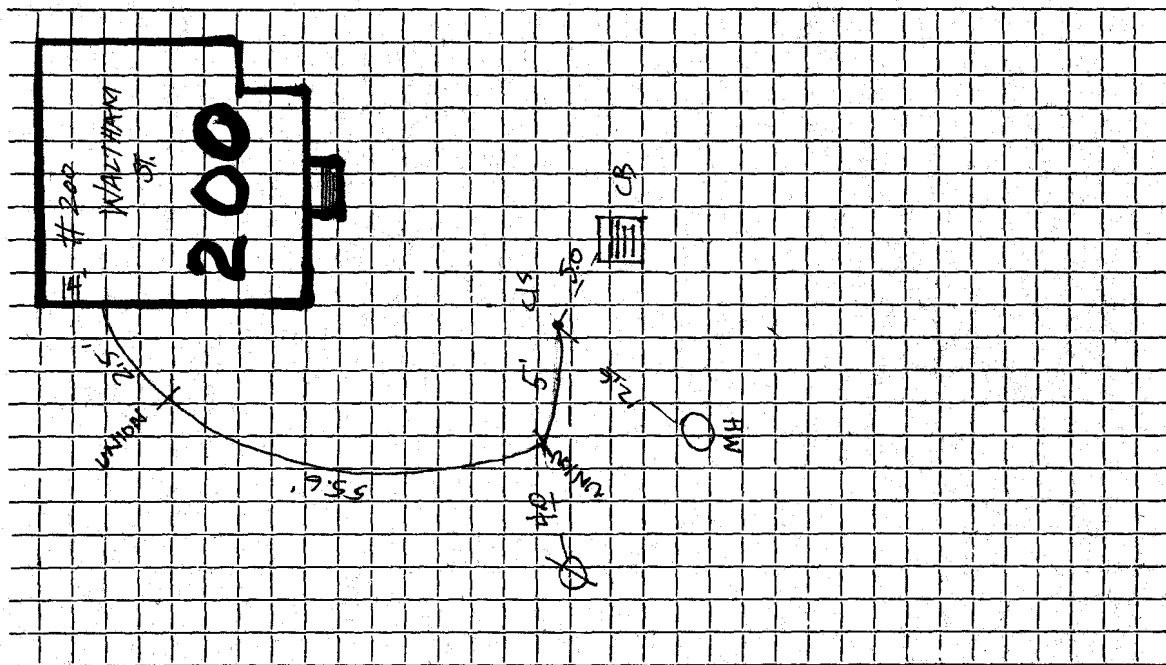

Connection made in Street.

Work completed 6/24/93 ARLEX OIL CORP.

Remarks: Killed old service 4-25-80