

WATER SERVICE RECORD

Name

Service No.

Address

202 Waltham Street

Location

40-5-LOT

Repair—Renewal—New Service

Man to Curbstop 812/1K Granite


Date	Material	Amount	Total	Date	Amount
8-21-12	23' 1" Copper				
	1" Corp	down 4.5"			
	1" Curbstop	down 5.4"			
	bufflo box				
EXIST	Renewal - Device				
1-21-80	55' 3/4" Copper				
	1 3/4 union 3-part				
	1 3/4" S + W				

DATE _____

TOWN OF LEXINGTON — BOARD OF PUBLIC WORKS

WATER DIVISION

Sketch of Service Here

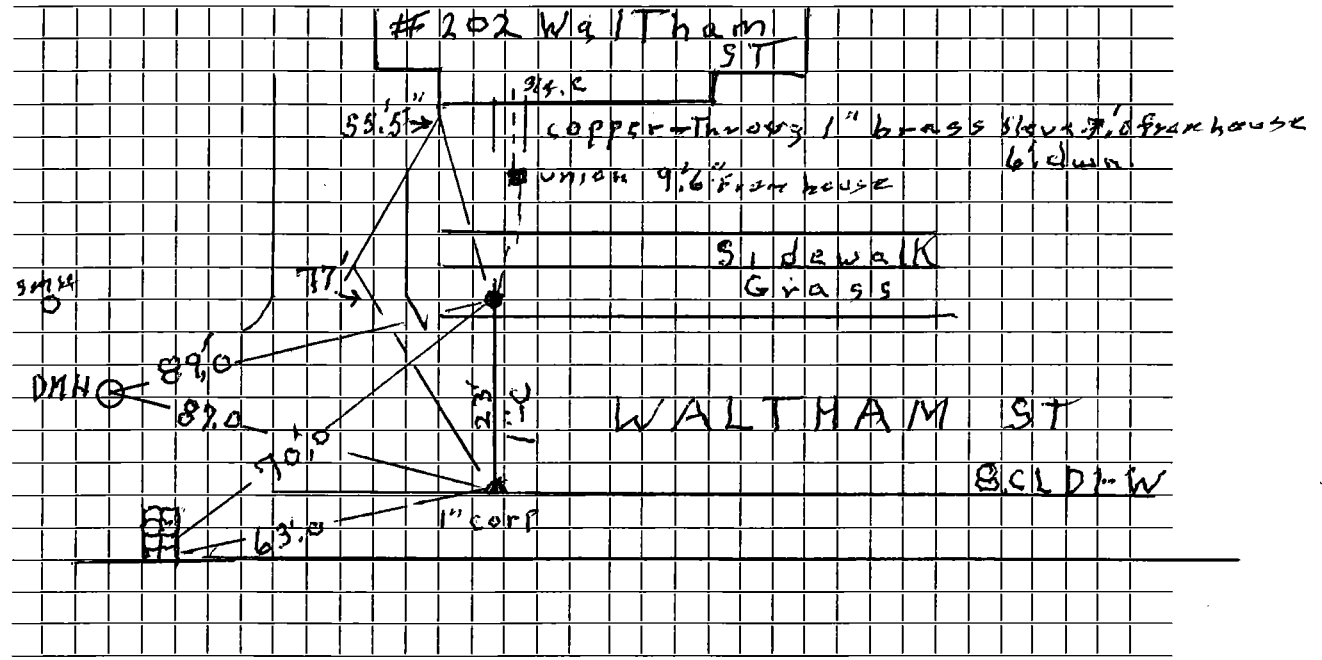

Connection made in Street. Work completed 8/21/12

Remarks: 3/4" Union 9' 6" from house

Sewer And Gas are next to water

.....