


DATE _____

TOWN OF LEXINGTON — BOARD OF PUBLIC WORKS

WATER DIVISION

Sketch of Service Here

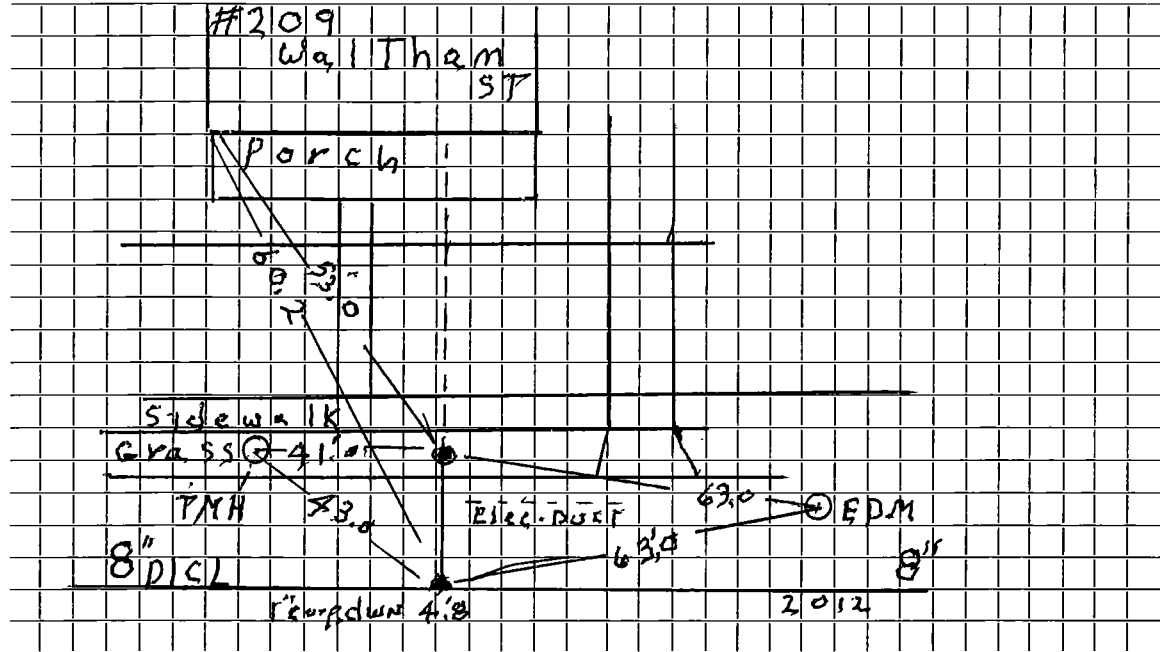

Connection made in Waltham, ST Street. Work completed 8/14/12

Remarks: Curb down 5.5

.....

.....