


TOWN OF LEXINGTON — BOARD OF PUBLIC WORKS

WATER DIVISION

Sketch of Service Here

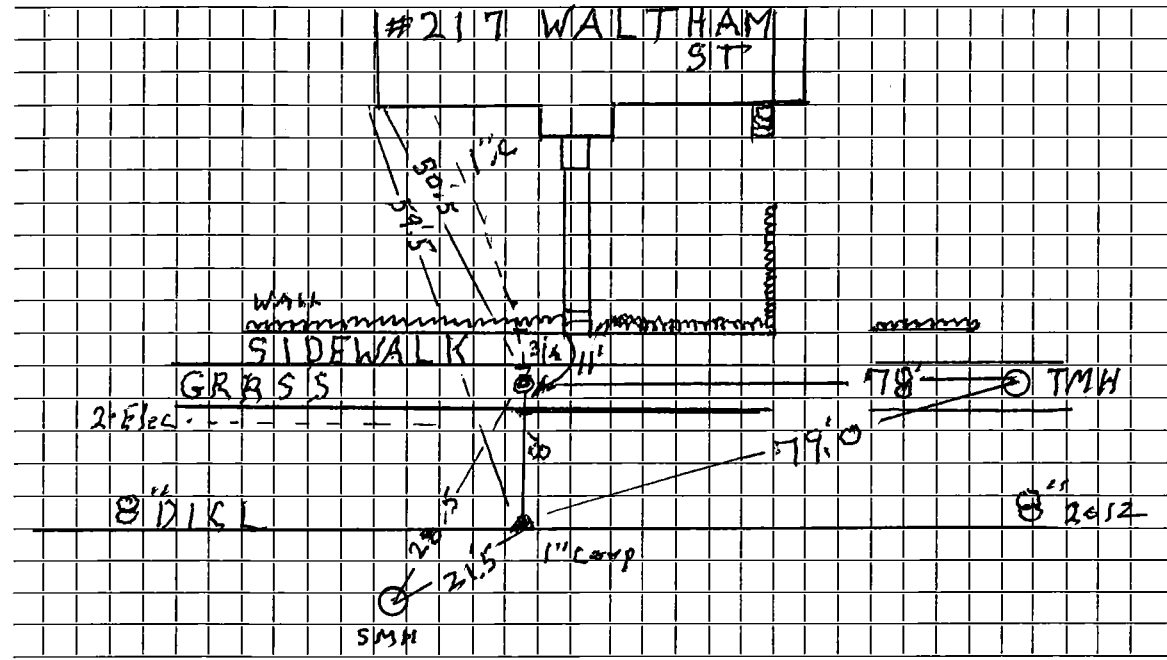

Connection made in Waltham St Street. Work completed 8/14/12

Remarks: Old Tie Shows 11' of 3/4" copper under sidewalk - 4x3/4 unions

.....
