

077 Mr G. Bousquet

Service No. ~~1943~~ 2821

~~61 Marrott Road, Lexington~~
222 Waltham St.

Location 222 Waltham Street

Kind of Pipe

Size

Size of Main

Repair—Renewal—New Service

Location

Date

Material

Amount

Total

Date

Amount

12/17/40

2 hrs. @ 60¢

1 20

Caution 2000-1

10% Overhead

12

1 32

51' 3/4" Copper tubing @ 19¢

9 69

1 3/4" C. x 1/2" I.S. & W.

2 25

1 hr. trucking @ 75¢

75

\$14 01

February 5, 1941 Paid

14 01

Bill sent 1/30/41

Labor

Hadley Press, Inc., Lexington

DATE 10-19-19

TOWN OF LEXINGTON—BOARD OF PUBLIC WORKS

WATER DIVISION
Cor. Skintling Rd.

The undersigned applies for a supply of water at No. Waltham St. and hereby agrees to comply with the rules and regulations as now, or at any future time, established by the Board of Selectmen.

Am't. of Estimate \$ 20⁰⁰

Owner Arthur G. Boussquet


Am't. Paid \$ _____

Address 64 Manett Rd

Builder _____

Lexington

Sketch of Service Here

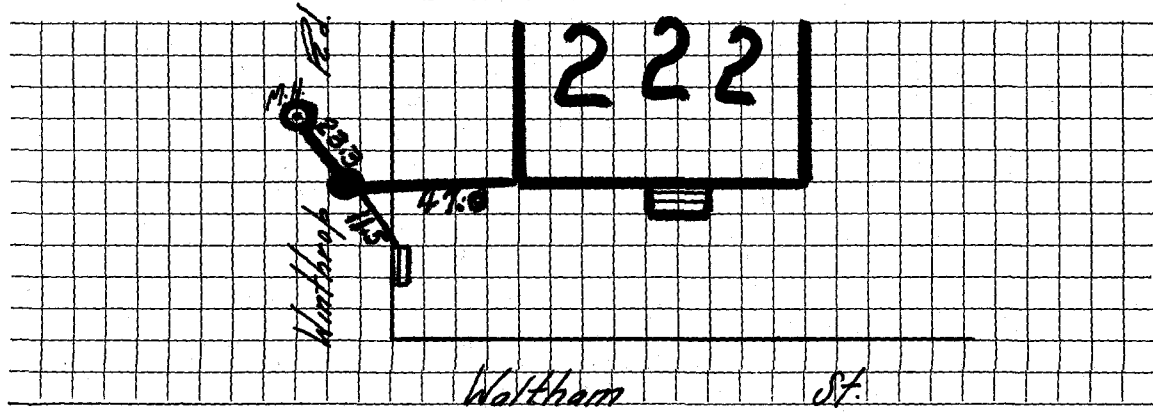

Connection made in _____ Street.

Work completed _____ 19

Remarks: