


TOWN OF LEXINGTON — BOARD OF PUBLIC WORKS

WATER DIVISION

#225

23021

Sketch of Service Here

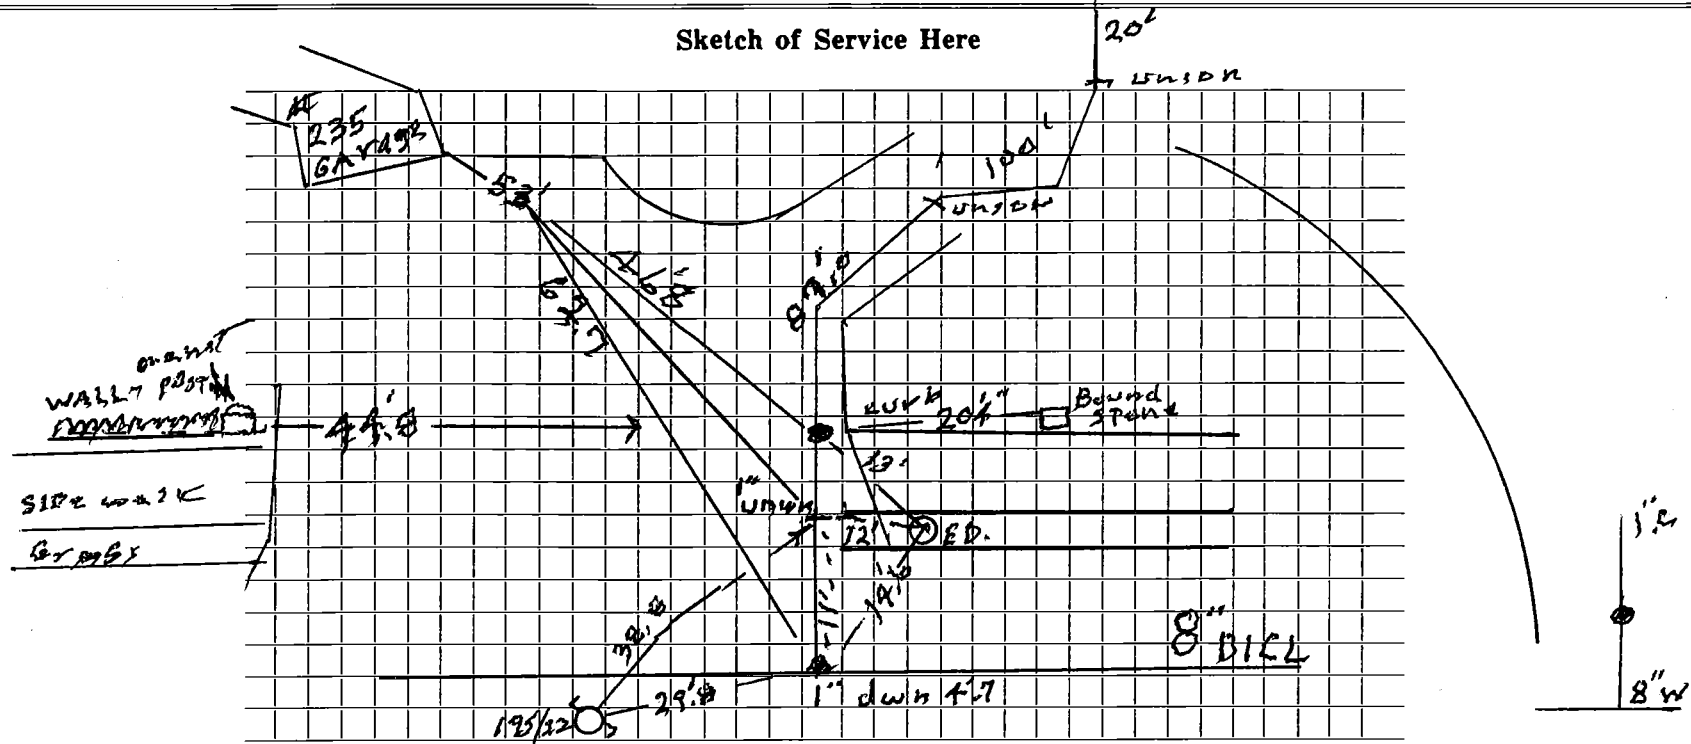

Connection made in..... Street. Work completed 8-15-12. Grange St.

Remarks: 3-Elec. Ducks / GAS-1.5 in.

1" Copper between 2 ducks banks