

WATER SERVICE RECORD

Name Daniel L. McCabe

Service No. 3

Address 229 Waltham Street

Location

Repair—Renewal—New Service W.O. #629 #4013 J.A. Cataldo Corp.

MAY 6 1985

Date	Material	Amount	Total	Date	Amount
10/6/83	Labor	263.78		4-11-85	
	10% O.H.	26.38	290.16		
	19' 1" Copper @ \$1.45		27.55		
	1 1" Corp.		23.15		
	1 1" Curb		29.75		
	1 Curb Box & Rod		22.52		
	35 Ton Gravel Crushed @ \$4.50		157.50		
	Patch		214.74		
	9 hrs. Trucking @ \$9.00		81.00		
	9 hrs. Trucking @ \$15.00		135.00		
	9 hrs. Town Shovel @ \$24.00		216.00		
			1197.37		
4/17/85	207' 1" copper tubing				
	2 1" comp.unions				
	1" stop & waste				


*Deposit  
Paid by Mark Moore*

*1197.37*


229

DATE \_\_\_\_\_

# TOWN OF LEXINGTON — BOARD OF PUBLIC WORKS WATER DIVISION

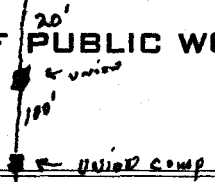

Sketch of Service Here

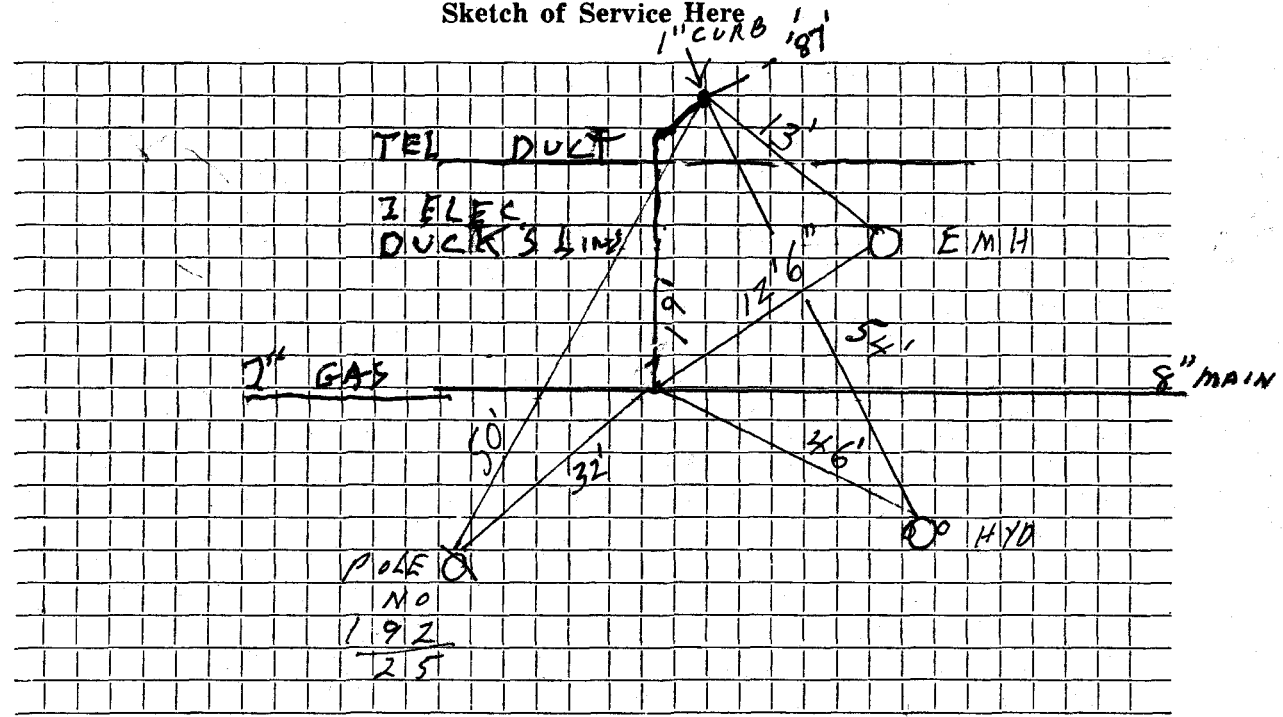

Connection made in ..... Street. Work completed .....

Remarks: THE WATER SERVICE GOES BETWEEN THE 2 ELEC DUCT LINES