

WATER SERVICE RECORD

Name

Service No.

Address

242 Waltham street

Location

ps. 40-221-10T

Repair—Renewal—New Service

Mam to Curbstop 812/117 Granite


Date	Material	Amount	Total	Date	Amount
8-21-12	Taped on 8" W				
27	1" Copper				
	1" Cap				
	1" Curb stop				
7-1959					
EXIST	65' 3/4" Copper				
	1 3/4 Union				
	3/4 x 1/2 9+ W				

DATE \_\_\_\_\_

TOWN OF LEXINGTON — BOARD OF PUBLIC WORKS

WATER DIVISION

Sketch of Service Here

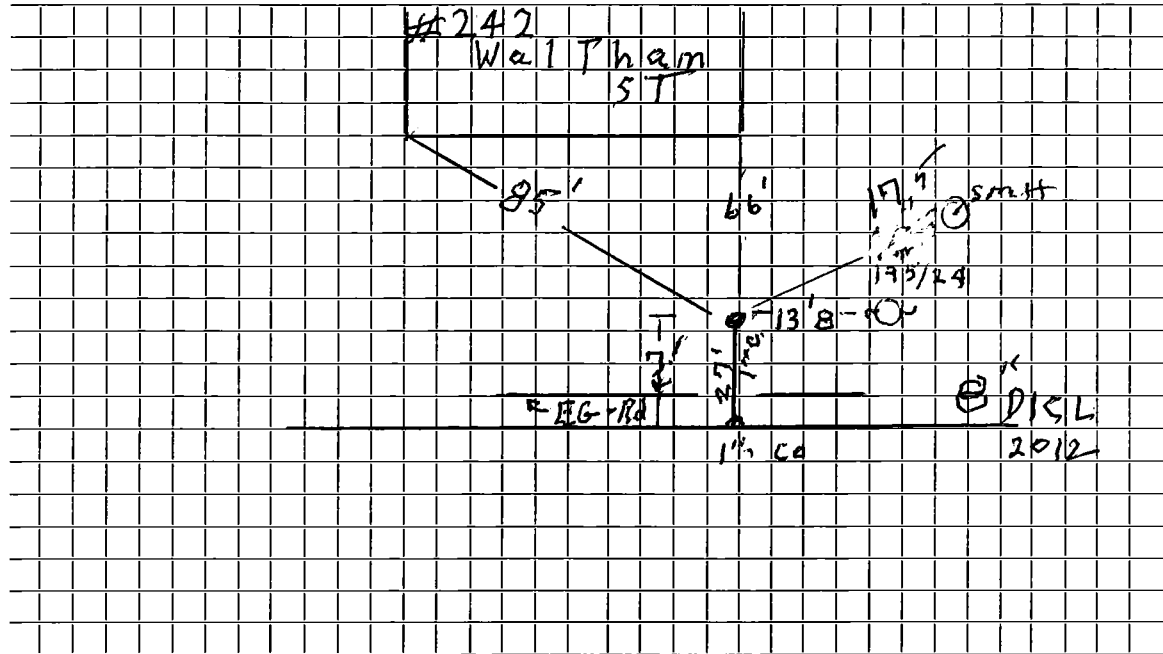

Connection made in ..... Street. Work completed ... 8-2-12 .....

Remarks: .. Killed 3/4" service on 12" W / Tap on new 8" W .....

.....  
.....