

WATER SERVICE RECORD

Name New High School

Service No.

Address 245 Waltham St.

Location pit near Waltham St.

~~REPAIRS~~ - New Service

Service is for lawn.


Date	Material	Amount	Total	Date	Amount
				TRENCH DUG BY CONTRACTOR:	
				<u>NON CHARGE</u>	
				8/5/53	Labor 31 29
				8/7/53	" 43 75
					180' - 1" copper tubing @ .48 86 40
					1 - 1" C. corp-cock 5 61
					2 - 1" C x 1" C. curb-cocks @ 6.80 13 60
					2 - 1" C x 1" C. unions 3pts. @ 2.26 4 52
					2 - 1" C x 1" I. unions 2pts. @ 1.40 2 80
					2 - 1" x 3/4" red. bushings @ .59 1 18
					1 - 1" x 3/4" I.W.H. stop & waste 4 50
					2 - 3/4" straight tail pieces @ .50 1 00
					500 cement brick @ 23.00 per M. 11 50
					1 pit cover and frame 9 88
					7 2/3 hrs. Littlefield shovel @ 7.50 57 50
					2 hrs. trucking @ .75 1 50
					275 03

DATE _____

TOWN OF LEXINGTON — BOARD OF PUBLIC WORKS

WATER DIVISION

Sketch of Service Here

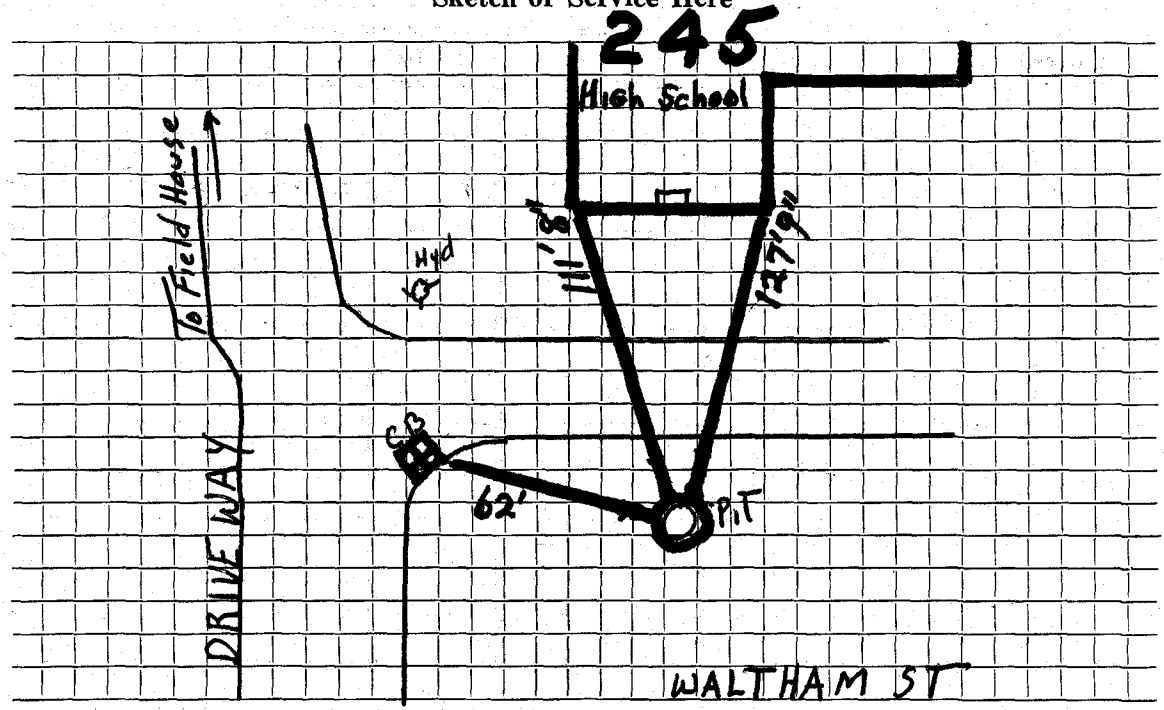

Connection made in Street. Work completed

Remarks: *METER. Removed. 7-6-1988 J.W.*

.....

.....