


DATE _____

TOWN OF LEXINGTON — BOARD OF PUBLIC WORKS

WATER DIVISION

Sketch of Service Here

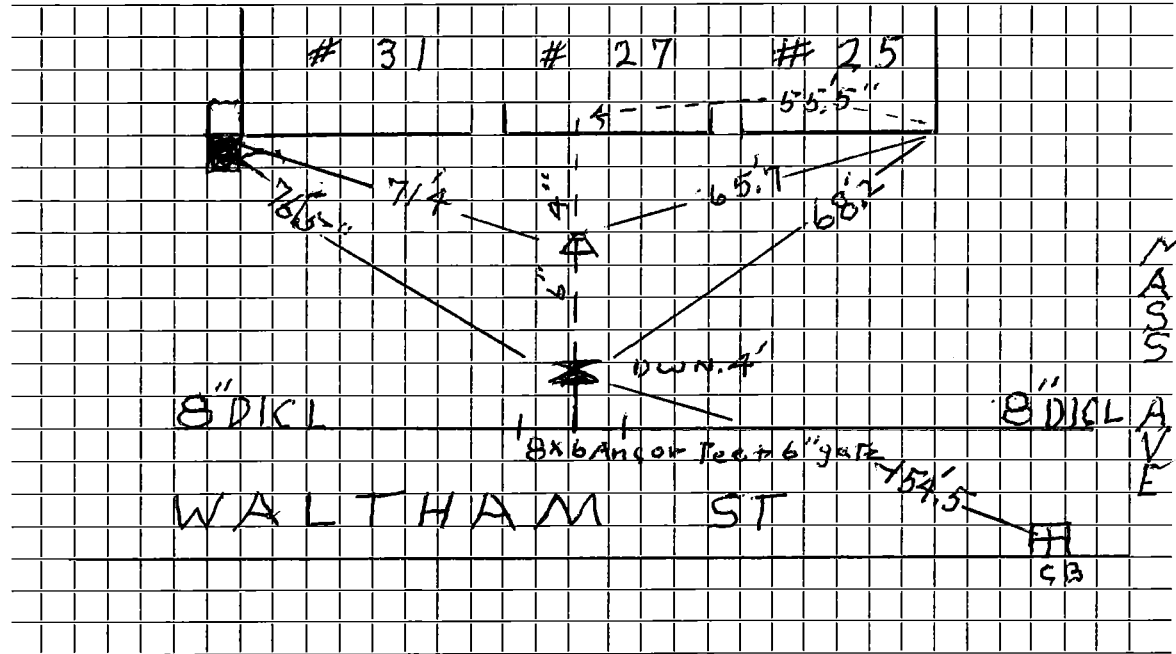

Connection made in Street.

Work completed Aug. 1911 Granes E.

Remarks: 4" Fire Main

.....
.....