

WATER SERVICE RECORD

Name **New High School**

Service No. **236**

Address **251 Waltham Street**

Location **Lexington, Mass.**

~~REPLACEMENT~~ - New Service

6" main *Com. 11-13-51*

Date	Material	Amount	Total	Date	Amount
10/2/51	Labor	70 17	70 17	9-27-51 Deposited	500 00
	10% overhead		7 02	11-13-51 Refunded	41 98
	32' -8" C.L. pipe @ 2.10		67 20		458 02
	1 - 8x8 Tee		33 68		
	1 -8" solid sleeve		13 05		
	1 -8" gate valve		72 00		
	1 -gate box		13 90		
	200 lbs.lead @ .22		44 00		
	10 hrs.Littlefield shovel@7.		70 00		
	4 hrs. trucking @ .75		3 00		
	patching 16 x 12		64 00		
			<u>458 02</u>		

DATE _____

TOWN OF LEXINGTON — BOARD OF PUBLIC WORKS
WATER DIVISION

Sketch of Service Here

A large rectangular area filled with a grid of small squares, intended for drawing a sketch of service details.

Connection made in Street. Work completed

Remarks:
.....
.....


WALTHAM ST

DATE Aug. 9, 1993

TOWN OF LEXINGTON — BOARD OF PUBLIC WORKS

WATER DIVISION

Sketch of Service Here

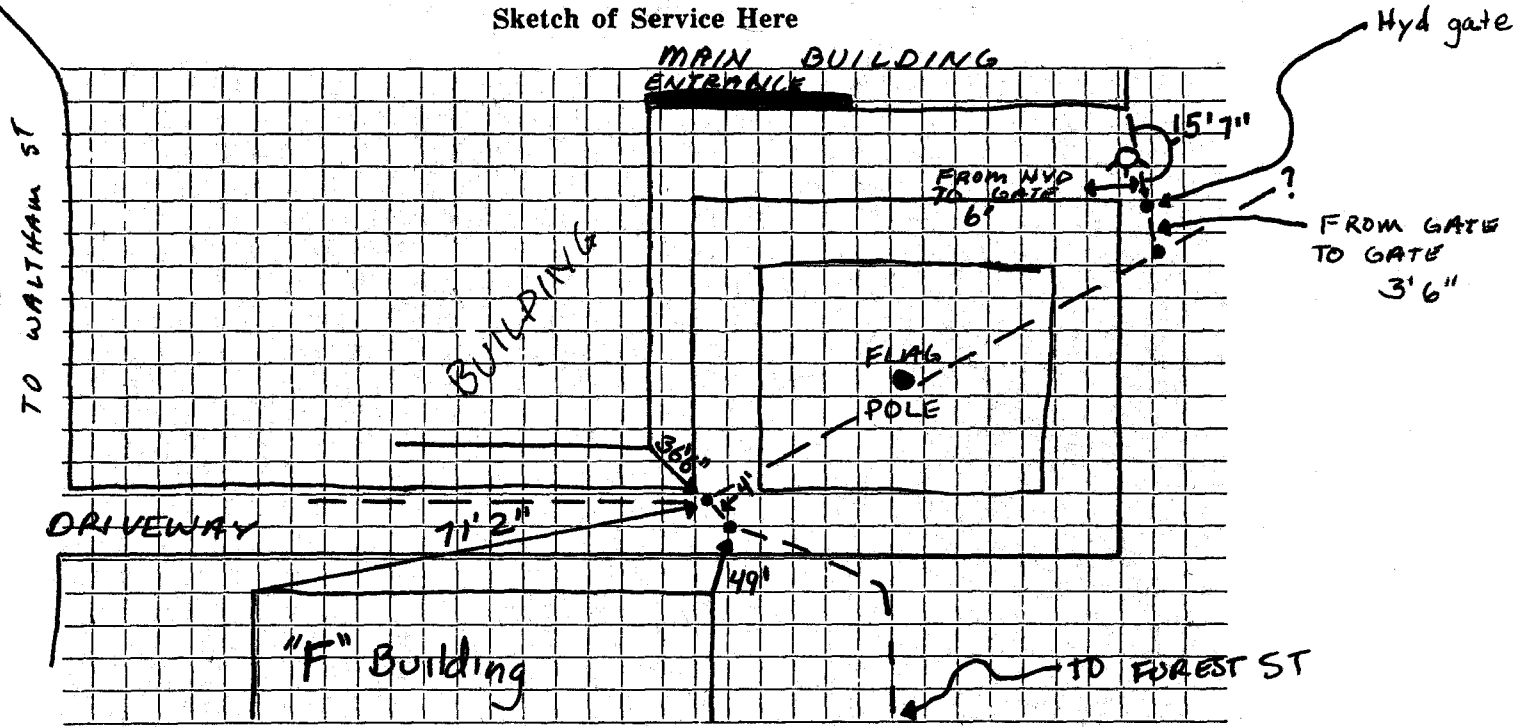

Connection made in Street. Work completed

Remarks: Ties for gates in flag pole court yard