

#-6764

WATER SERVICE RECORD

Name R.J. Foley Realty Trust

Service No. 17

Address 256 Waltham Street #D

Location

~~Repair~~ ~~Renewal~~ ~~New Service~~ W.O. #6533 Cont. DeFlice Bros. Permit #979

NOV 18 1968


Date	Material	Amount	Total	Date	Amount
4/2/68	Labor	131.68		4-17-68	650 00
5/1/68	"	37.38		11-18-68	309 35
6/3/68	"	20.61	189.67		340 65
	10% O.H.	18.97	208.64		
28'	1" Copper Tubing	27.	27.72		
1	1" Corporation		10.66		
1	1" Curb Cock		14.43		
1	Box and Rod		5.10		
1	Ton Gold Patch		5.50		
2	Ton Hot Taps		11.60		
5	Hrs. Trucking		15.00		
4	Hrs. Shovel		26.00		
2 1/2	Compressor		12.50		
1/2	Hr. Roller		1.50		
	Trailer		2.00		
5-10-68	34' 3/4" Copper tubing		340.65		

Deposit  
Return

DATE \_\_\_\_\_

# TOWN OF LEXINGTON — BOARD OF PUBLIC WORKS

## WATER DIVISION

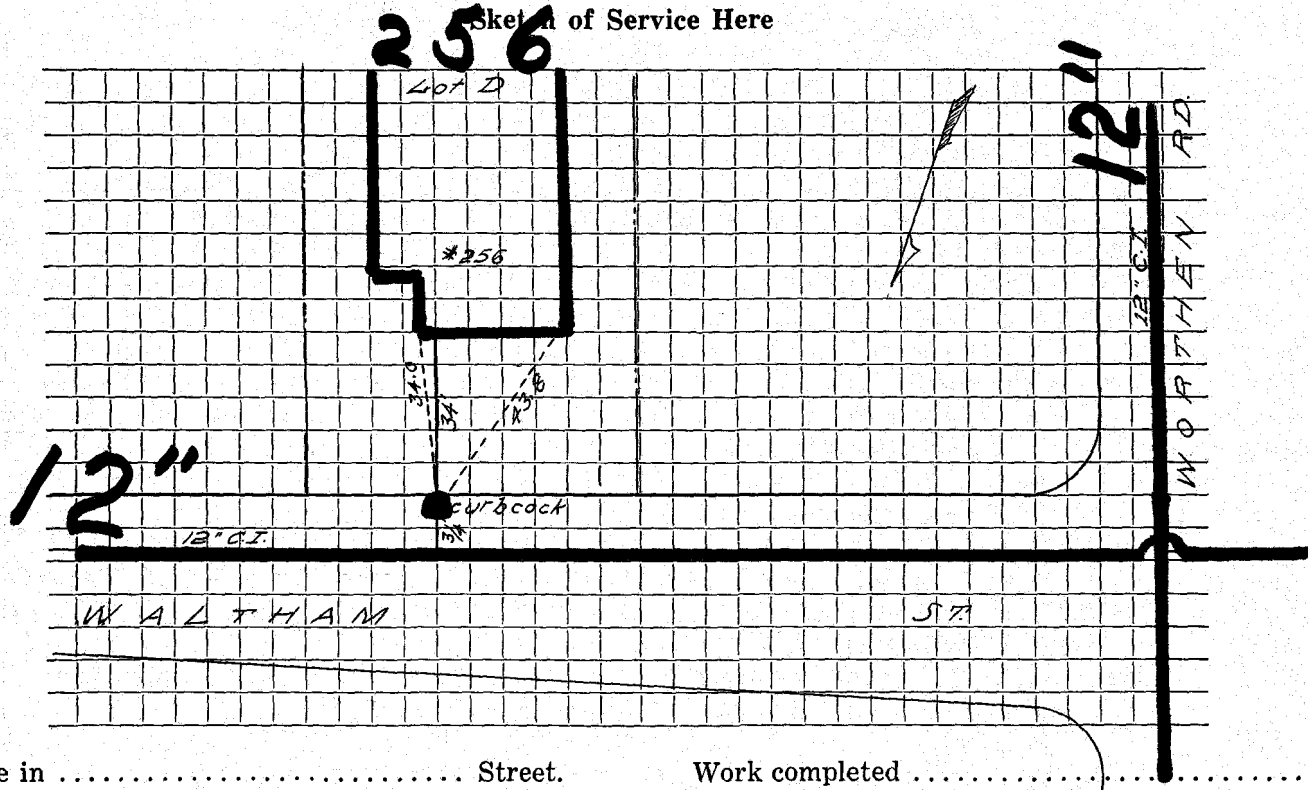

Connection made in ..... Street. Work completed .....

Remarks: .....

.....

.....