


TOWN OF LEXINGTON — BOARD OF PUBLIC WORKS

WATER DIVISION

Sketch of Service Here

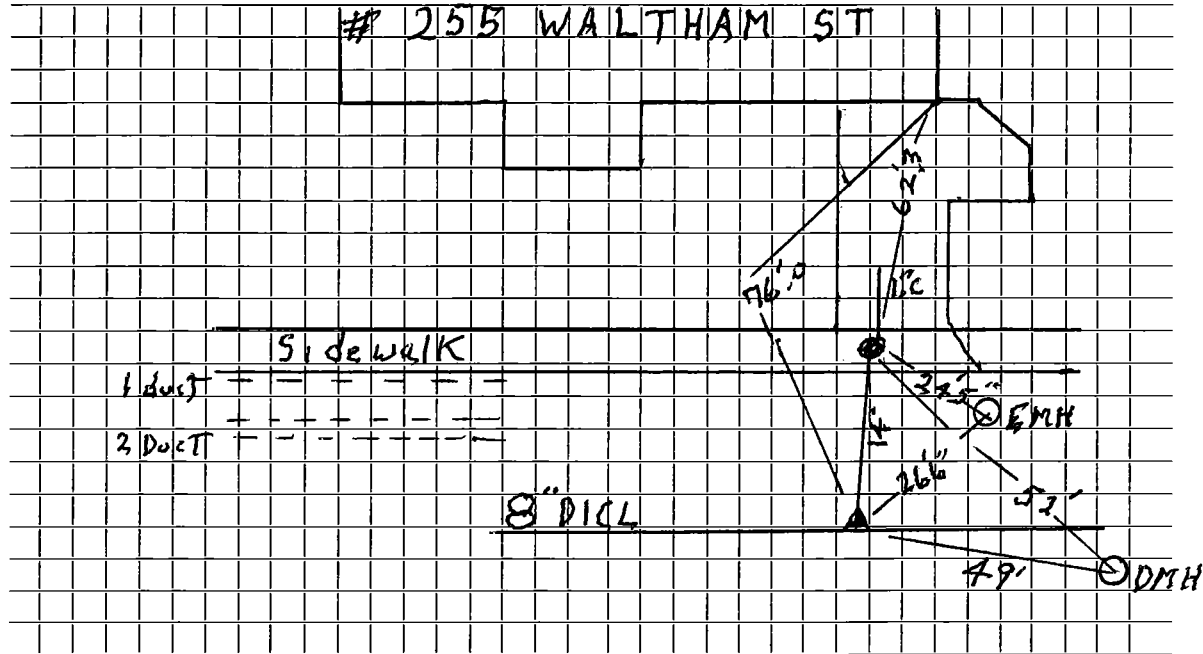

Connection made in Street. Work completed 8-20-12

Remarks: ... Curb down 3'8" / Sump down 4'8"

.....

.....