


Inspected

DATE 5/5/18

TOWN OF LEXINGTON — BOARD OF PUBLIC WORKS

WATER DIVISION

Sketch of Service Here

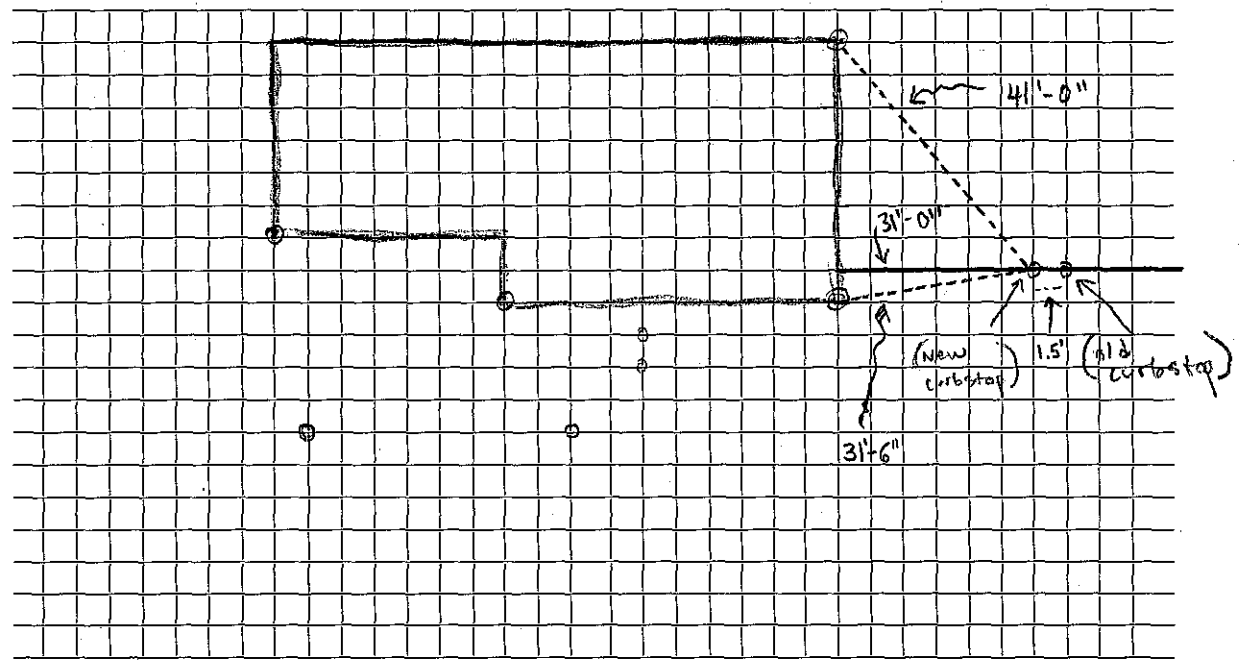

Connection made in 267 Waltham St Street. Work completed

Remarks: New Gate Down 4'-8"

.....
.....