


DATE _____

TOWN OF LEXINGTON — BOARD OF PUBLIC WORKS

WATER DIVISION

Sketch of Service Here

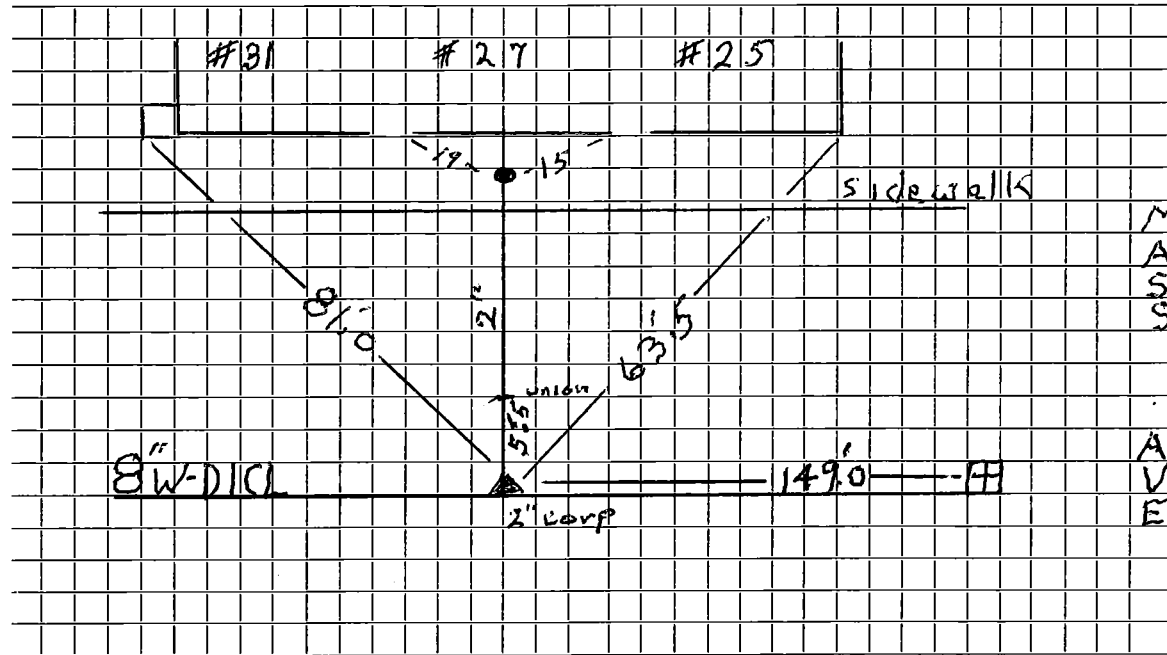

Connection made in W. Thayer St. Street.

Work completed 8-15-11 Greenase.

Remarks:

.....

.....