

WATER SERVICE RECORD

Name

Service No.

Address 277 Waltham St.

#6875

Location

Repair—Renewal—New Service W.O. # 9403

Date	Material	Amount	Total	Date	Amount
1-12-71	55' 1" Copper				
	2 1" c. X 1" l. 2 Part Union				
	2 1 1/2" X 4" C. L. Nipples				(OUTSIDE)
	2 1 1/2" X 1"			4/1/71	Labor 121 28
	1 1 1/2" Repair Clamp			4/30/71	" 36 52
				20'	1" Copperpipe 1.01 20 20
				1	1" Corporation 10 66
				1	1" Curb Cock 14 43
					Box & Rod 5 10
				1/2	Ton cold patch 8.00 2 00
					Frame & Cover (used) 50 50
				2	1" Copper to iron 4.04 8 08
				3	Hrs. Trucking 3.00 9 00
				1	" Compressor 3 00
				4	" Shovel 4.00 16 00
				1	" Loader 4 00
					<u>300 27</u>


MAY HAVE BEEN 7 WAY BRANCH

DATE _____

TOWN OF LEXINGTON — BOARD OF PUBLIC WORKS

WATER DIVISION

Sketch of Service Here

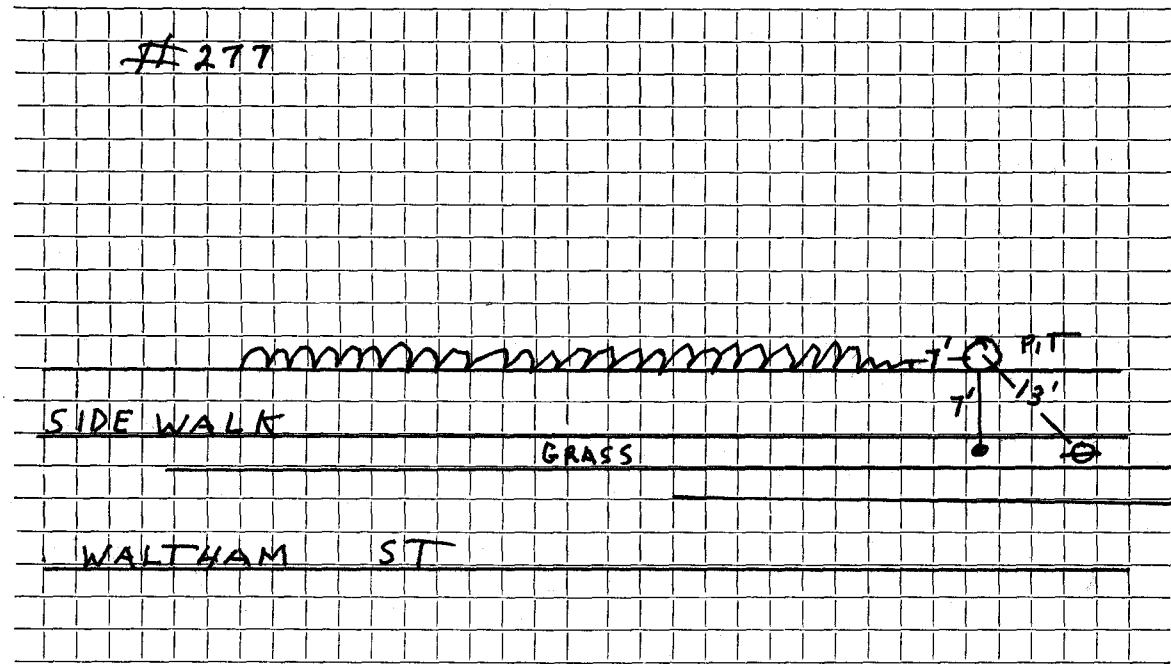

Connection made in Street. Work completed


Remarks:
.....
.....

DATE 3/8/59

TOWN OF LEXINGTON — BOARD OF PUBLIC WORKS

WATER DIVISION

Sketch of Service Here

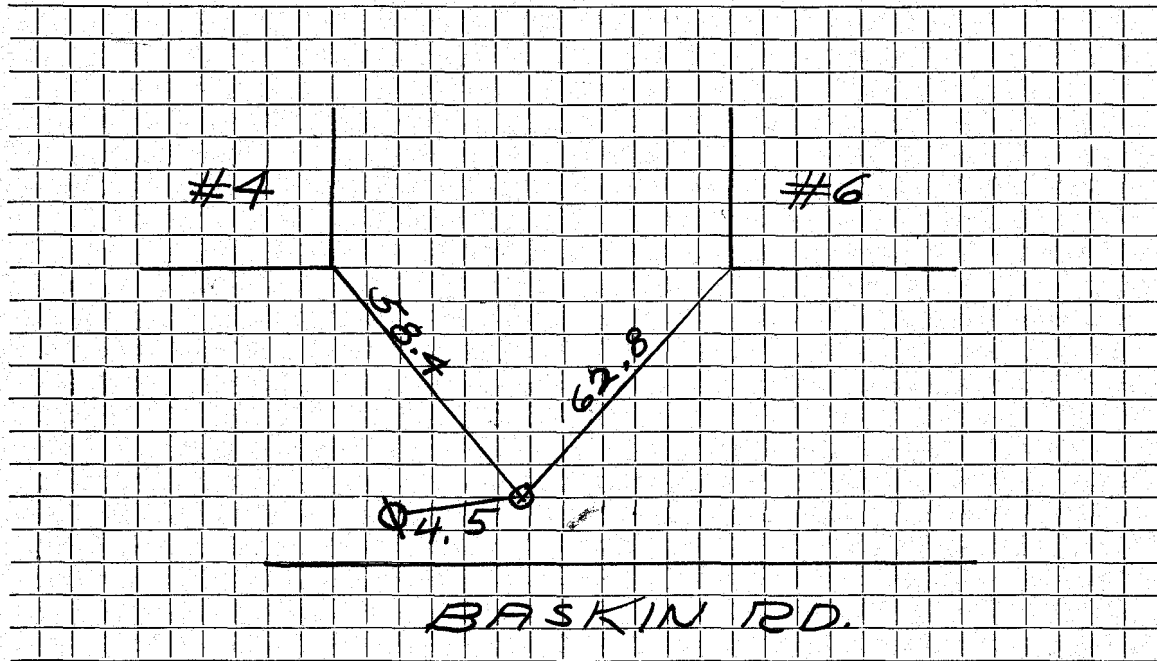

Connection made in BASKIN RD. Street. Work completed

Remarks: LOCATED THIS CURB 8/97. WHAT IT IS USED FOR?

.....
.....