

Name Harry F. Conner

Service No. 77 3182

Address 287 Waltham Street

Lexington, Mass.

Location 287 Waltham Street

Kind of Pipe

Size

Size of Main

~~Repair-Renewal~~ - New Service

Com 12-16-46

Location

Date

Material

Amount

Total

Date

Amount

Sept. 5, '46

Labor

9 90

9 90

Sept 5 '46

Deposited
Paid

26 00

10% Overhead

99

Jan 21 '47

10 42

52' - 3/4" Copper Tubing @.23

11 96

Non-Charge

35 42

1 - 3/4" C x 3/4" I.W.H. S & W

2 82

Sept. 5, '46 Labor

16 89

Patching 9' x 3'

9 00

13' - 3/4" Copper Tubing @.23

2 99

Trucking 1 hr. @.75

75

1 - 3/4" C Corp-cock

2 70

35 42

1 - 3/4" C x 3/4" C Curb-cock

3 30

1 - Box & Rod

3 35

1 - 1/2" Straight Tail Piece

50

1 - 3/4" Offset Tail Piece

50

Compressor 2 hrs. @ 1.75

3 50

Trucking 1 hr. @.75

75

Labor

34 48

Bill sent 12-17-46

DATE _____

TOWN OF LEXINGTON—BOARD OF PUBLIC WORKS

WATER DIVISION

The undersigned applies for a supply of water at No. _____ St. and hereby agrees to comply with the rules and regulations as now, or at any future time, established by the Board of Selectmen.


Am't. of Estimate \$ _____

Owner _____

Am't. Paid \$ _____

Address _____

Builder _____

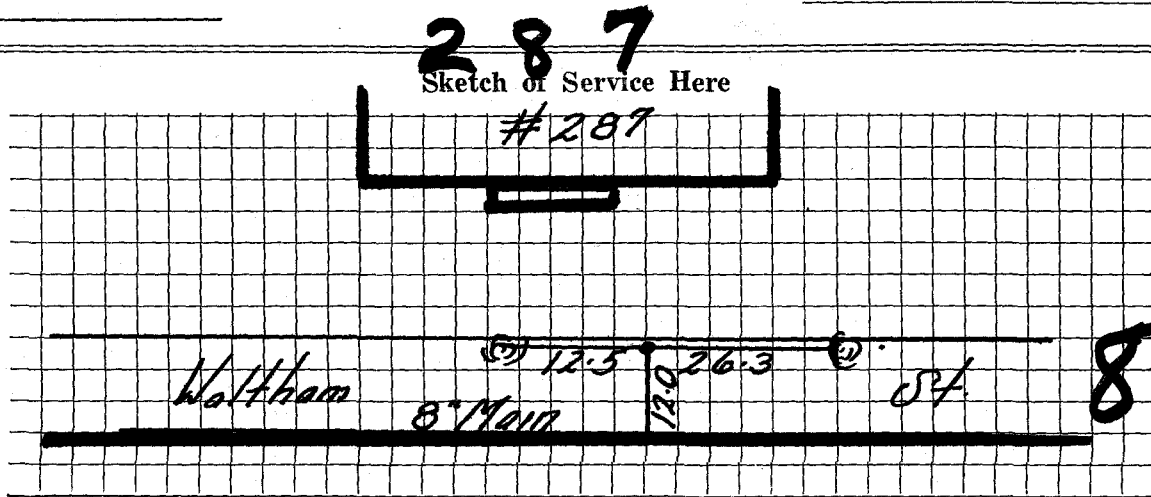

Connection made in _____ Street.

Work completed _____ 19

Remarks: