


DATE _____

TOWN OF LEXINGTON — BOARD OF PUBLIC WORKS

WATER DIVISION

Sketch of Service Here

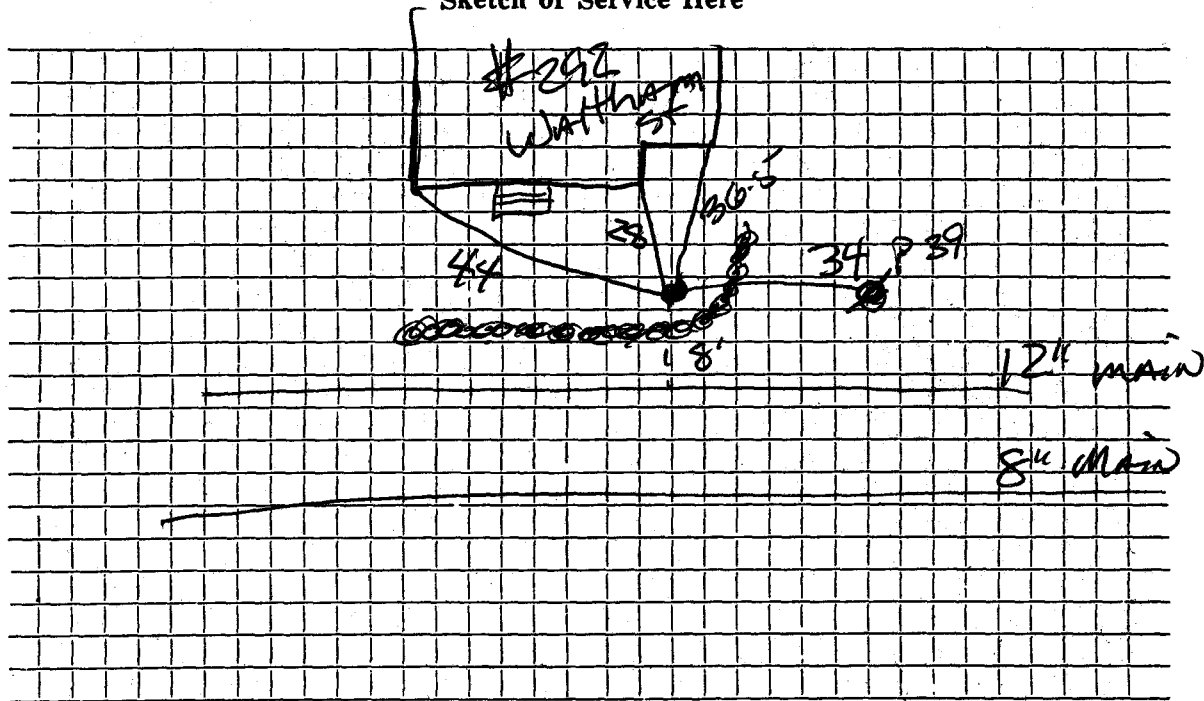

Connection made in Street. Work completed

Remarks: 7-30-79 from curb to 8" main 32'8" old service
killed at 8" • from curb line on odd side to 8" 9'6"