

WATER SERVICE RECORD

Name Oscar Carlson

Service No. 55

Address 295 Waltham Street

Location

~~Repair~~ ~~Renovate~~ — New Service

Comm 11-17-58

Date	Material	Amount	Total	Date	Amount
5/24/58	Labor	95 64		4-25-58	Deposit 35 00
	10% Overhead	9 56	105 20	12-4-58	Paid 34 31
	120' 3/4" Copper Tubing		44 40		Abated 99 15
	1 3/4" Cx 1/2 I.W.H. Stop & Waste	5 84			NON CHARGE 168 46
	1 3/4" C3 Part Union		2 27	5/22/58	Labor 11 96
	10 x 3 Patch		10 00		15' 3/4" Copper Tubing 5 55
	1 Hour Trucking @ 75		75		1 3/4" C Corp Cock 4 64
			168 46		1 3/4" C Curb Cock 6 03
			99 15		1 1/2 Straight Tail Piece 50
			69 31		1 1/2 Off Set Tail Piece 50
					2-Hours-Town-Shovel @ 6-50-
					1 Hour Trucking @ 75 75
					2 Hours Town Shovel 13 00
					42 93


Bill sent 11-17-58 135.46

DATE _____

TOWN OF LEXINGTON — BOARD OF PUBLIC WORKS

WATER DIVISION

Sketch of Service Here

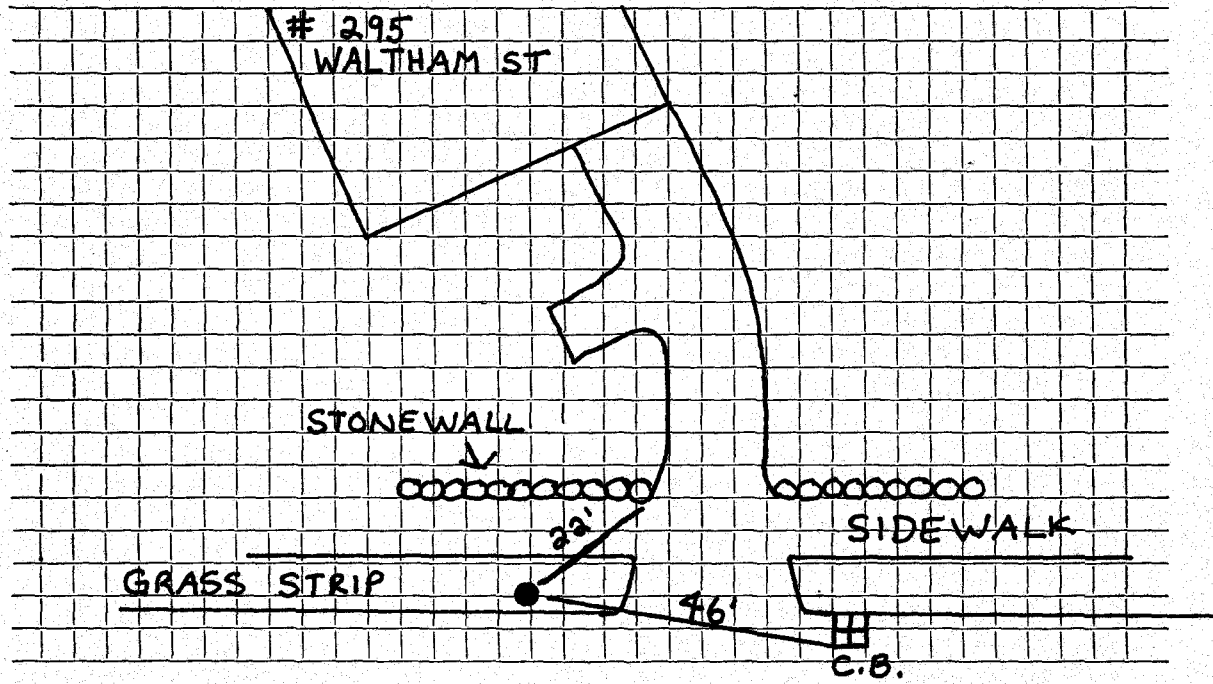

Connection made in Street. Work completed

Remarks:
.....
.....