

Name

Service No. 2827

Address 296 Waltham Street

Location 296 Waltham Street

Kind of Pipe

Size

Size of Main

Repair—Renewal—New Service

Location

Date

Material

Amount

Total

Date

Amount

Labor

DATE _____

TOWN OF LEXINGTON—BOARD OF PUBLIC WORKS

WATER DIVISION

The undersigned applies for a supply of water at No. _____ St. and hereby agrees to comply with the rules and regulations as now, or at any future time, established by the Board of Selectmen.

Am't. of Estimate \$ _____

Owner

I. J. Carter


Am't. Paid \$ _____

Address

296 Waltham St

Builder _____

Sketch of Service Here

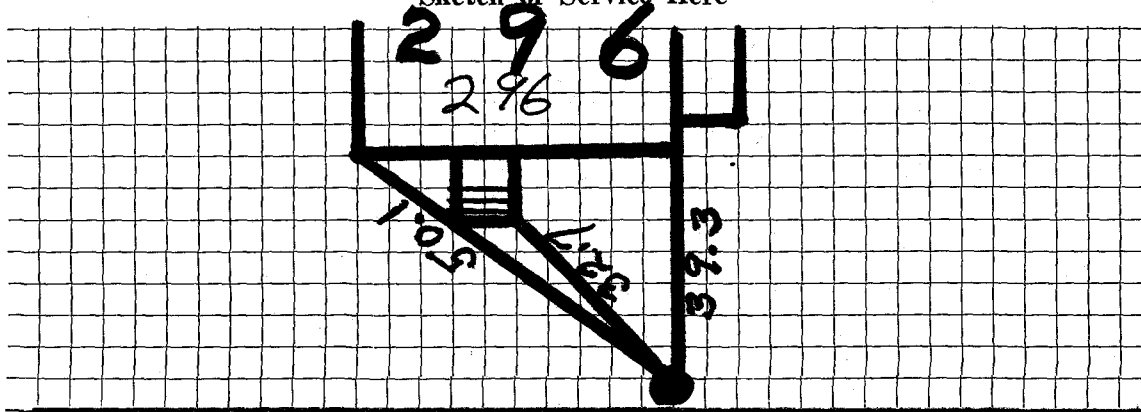

Connection made in Waltham St Street.

Work completed _____ 19

Remarks: