

WATER SERVICE RECORD

Name

Service No.

Address

300 Waltham St

Location


Repair—Renewal—New Service

Date	Material	Amount	Total	Date	Amount
10-23-00	Inside RENEWED 38' - 1" Copper 1 - 3/4" x 1" curb adaptor 1 - Buffalo Box			9-16-46	26' 3/4" Copper 3/4" Curb 3/4" Corp
10/15/05	Inside renewal 40 - 1" copper P. Rose				

DATE \_\_\_\_\_

TOWN OF LEXINGTON — BOARD OF PUBLIC WORKS  
**WATER DIVISION**

Sketch of Service Here

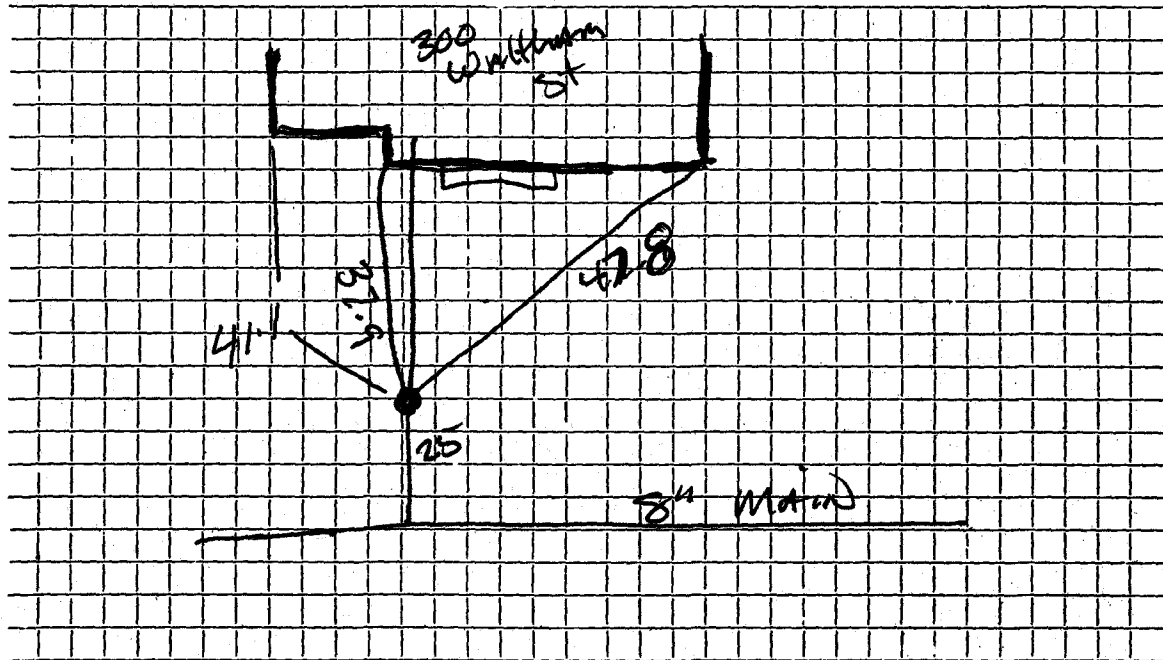

Connection made in ..... Street. Work completed .....

Remarks: .....  
.....  
.....