

WATER SERVICE RECORD

#6273

Name James L. Douglass

Service No. 172

Address (328 Waltham St.)

Location ~~Md 11 220 Waltham St.~~

~~Repair - Renewal~~ - New Service

Comm 12-1-58

Date	Material	Amount	Total	Date	Amount
9/16/58	Labor	25 22		8-13-58	Deposit 75 00
	10% Overhead	2 52	27 74	12-29-58	Paid 4 65
	65'-3/4" Copper Tubing @.37		24 05		79 65
	1-3/4" C x 1/2 IWH Stop & Waste	5 84			NON CHARGE
	1-3/4" C 3 part Union	2 27	9/16/58		
	10 x 3 Patch		10 00	Labor	2 61
	2 hrs. Pippin @1/50		9 00	9/27/58	
	1 hr. Trucking @.75		75	Labor	3 62
			79 65	16'-3/4" Copper Tubing @.37	5 92
2-3-78	Repair			1-3/4" C Corp Cock	4 64
	25' 3/4 COPPER			1-3/4" C Curb Cock	6 03
	1 3PART Union			1 Box & Rod	5 00
				1-1/2 Straight Tailpiece	50
				1-1/2 Offset Tailpiece	50
					28 82


Bill sent 12-1-58 4.65

DATE _____

TOWN OF LEXINGTON — BOARD OF PUBLIC WORKS

WATER DIVISION

Sketch of Service Here

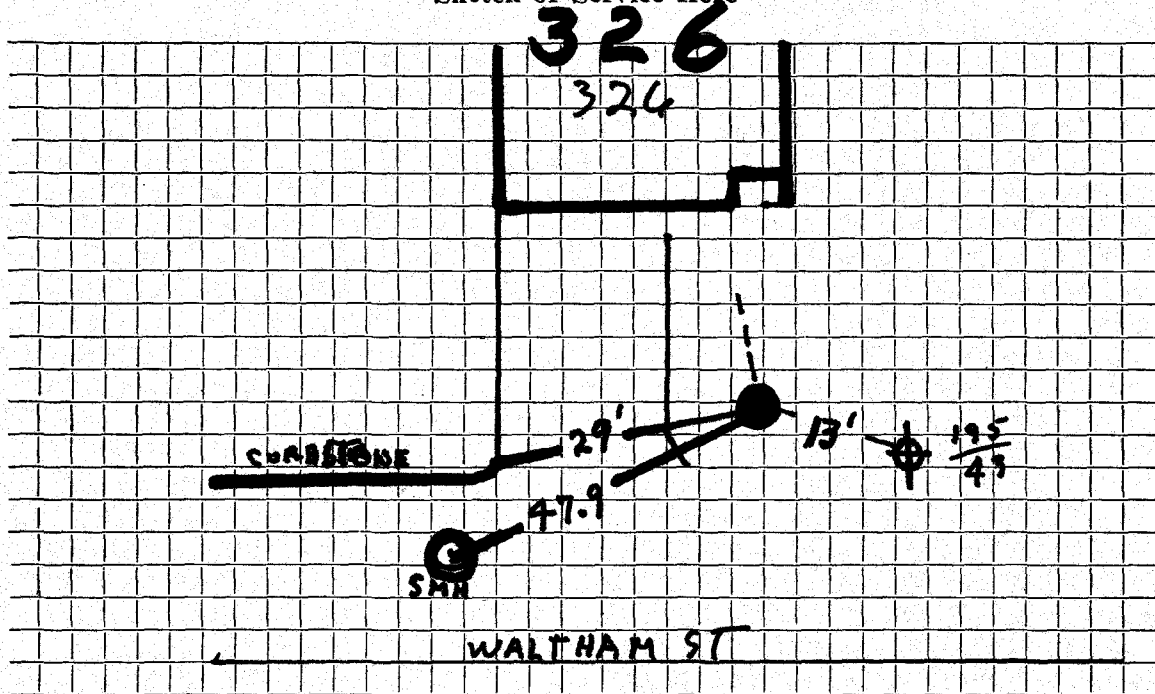

Connection made in Street. Work completed

Remarks:

.....
.....