

WATER SERVICE RECORD

Name GINGER CHAN

Service No.

Address 334 WALTHAM ST.

Location


Repair—Renewal New Service

Date	Material	Amount	Total	Date	Amount
10-2002	1" COPPER				
	SEE PLAN FILED UNDER ST. NUMBER @ ENGINEERING DEPT				
	1" Curb & Top				
	1x2 1/2 Bed.				
	baffle box				
7/17/86	out				
	4' 3/4 copper				
	3/4 carp.				

DATE OCT. 2002

TOWN OF LEXINGTON — BOARD OF PUBLIC WORKS
WATER DIVISION

Sketch of Service Here

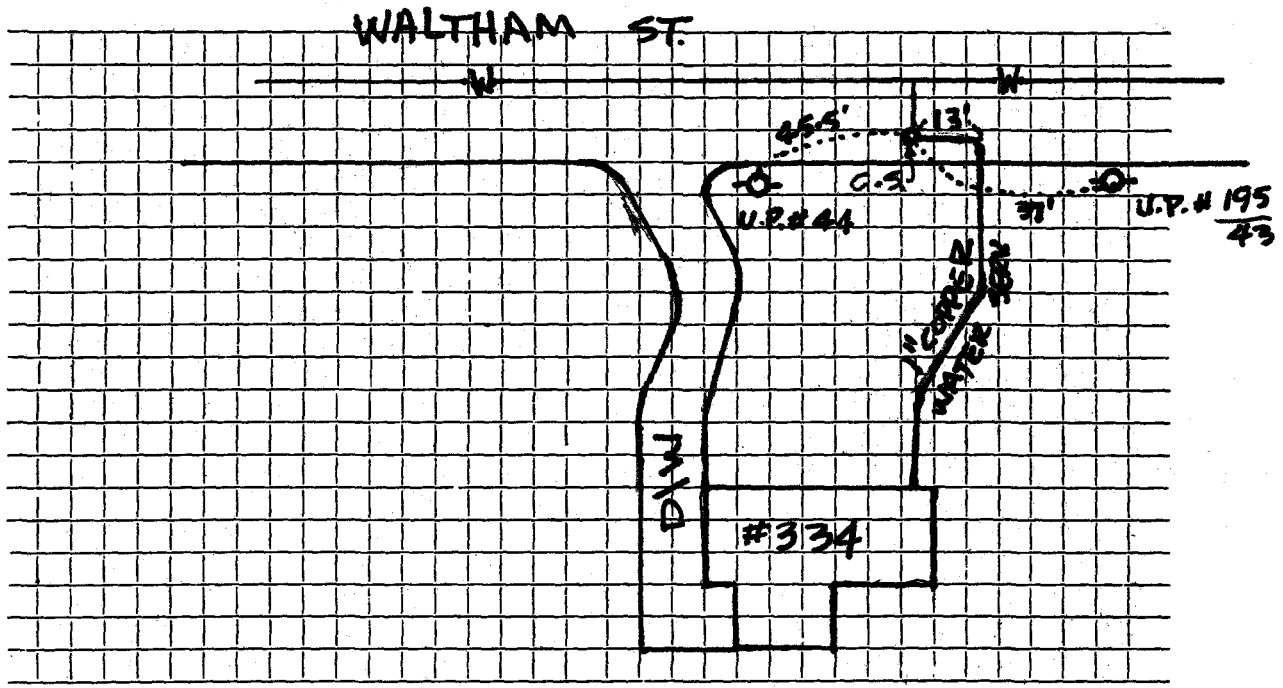

Connection made in WALTHAM ST. Street. Work completed J.P. YARA

Remarks: