


DATE _____

TOWN OF LEXINGTON — BOARD OF PUBLIC WORKS

WATER DIVISION

Sketch of Service Here

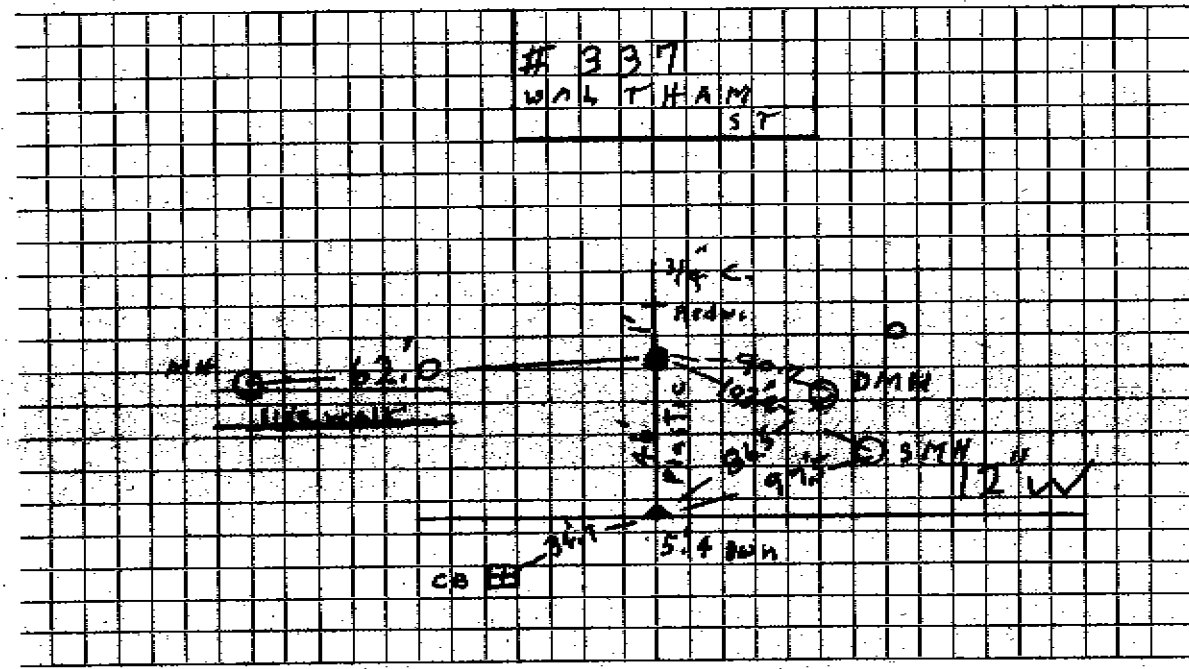

Connection made in Waltham St Street. Work completed 11/17/09 PAO

Remarks: Comp. To. Curb. 1" Plastic Pipe