

WATER SERVICE RECORD

#184

Name Benjamin Gott

Service No. 281

Address 342 Waltham Street

Location

~~REPAIR~~ ~~RENEWAL~~ - New Service


Comm. 12-3-56

Date	Material	Amount	Total	Date	Amount
9/17/56	Labor	22 03		9-10-56	Deposit 100 00
	10% overhead	2 20	24 23	12-3-56	Refund 19 00
	35' - 3/4" Copper tubing @ .4850	16 98			NON CHARGE 81 00
	1 - 3/4" Cx 1/2 I.W.H. Stop & Waste	4 96		9/17/56	Labor 5 70
	2 hrs. trucking @ .75	1 50			10' - 3/4" Copper tubing @ .4850 4 85
	3 1/3 hrs. Littlefield Shovel @ 8.50	28.33			1 - 3/4" C. Corp Cock 4 64
	5' patch		5 00		1 - 3/4" C. Curb Cock 5 94
			81 00		1 Box & Rod 4 62
					1 - 1/2 Straight tailpiece 50
					1 - 1/2 Offset tailpiece 50
					2 hrs. Littlefield Shovel @ 8.50 17 00
					43 75

TOWN OF LEXINGTON — BOARD OF PUBLIC WORKS

WATER DIVISION

Sketch of Service Here

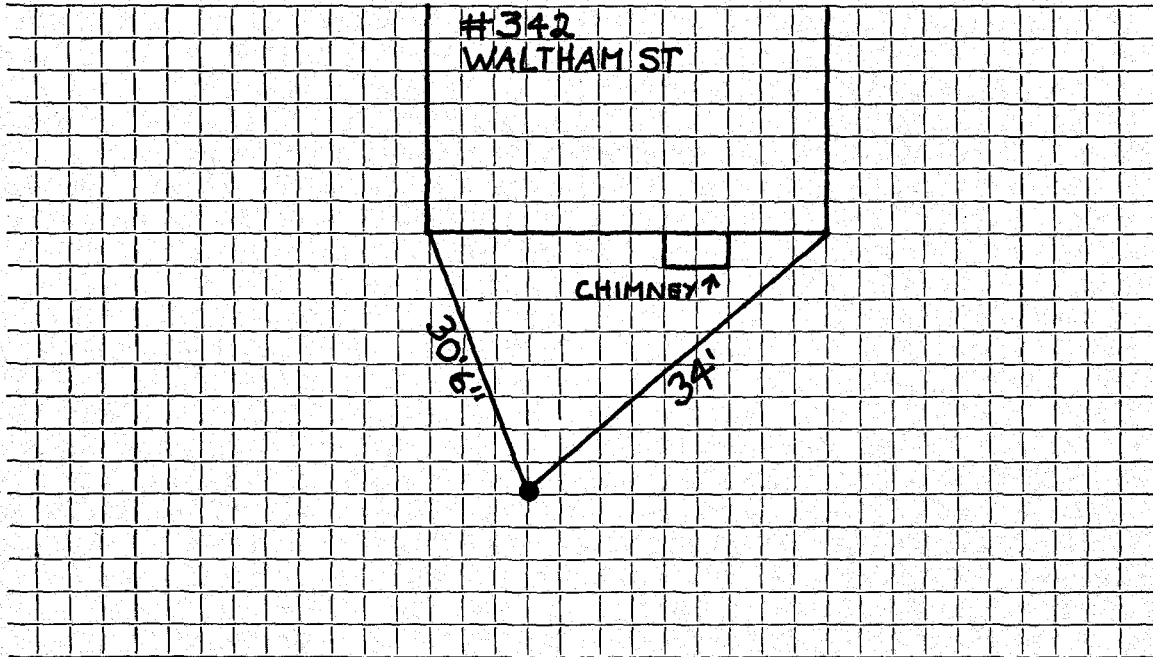

Connection made in Street. Work completed

Remarks:
.....
.....