

# WATER SERVICE RECORD

Name

Service No.

Address **345 Waltham ST**

Location

**Lot 270**

Repair—Renewal—New Service


Date	Material	Amount	Total	Date	PAO Corp	Amount
5/12/50	3/4" or Maybe Iron			11/12/07	48' 1" Plastic Pipe	
					1-1/2" 1" Plastic	
					1 1/2" 3/4 Reducer	
					1 1" Corp	4.8 Pumps
					1 1" Corp STOP	4.5 Pumps
					buff to box	

DATE \_\_\_\_\_

TOWN OF LEXINGTON — BOARD OF PUBLIC WORKS

WATER DIVISION

Sketch of Service Here

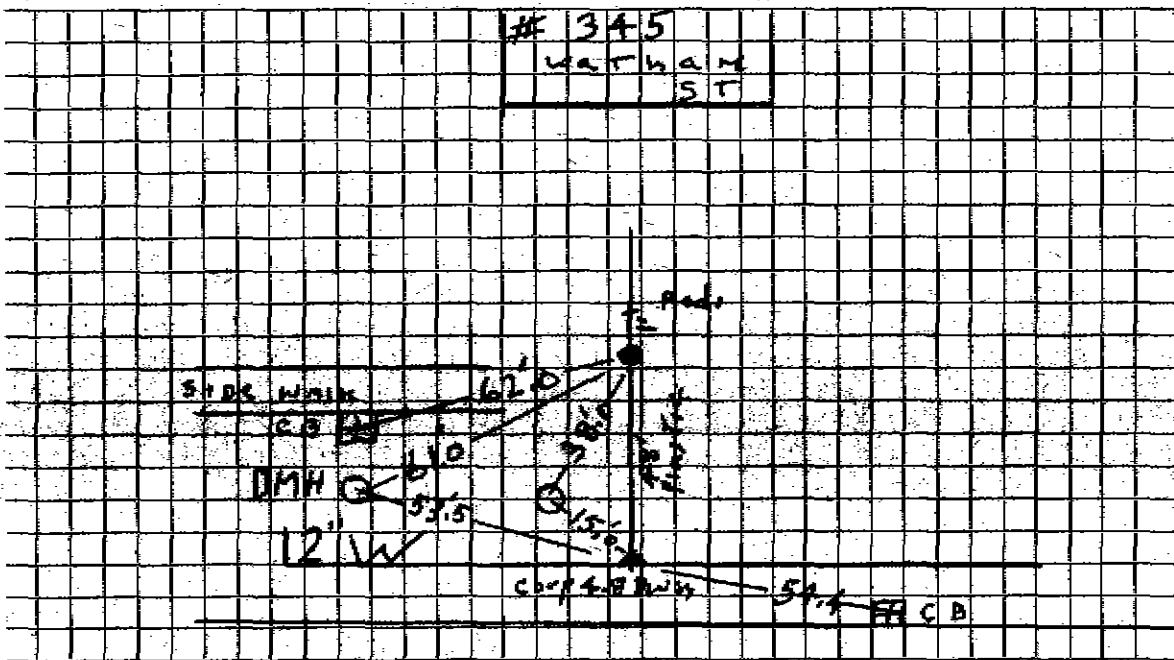

Connection made in Watham St Street.

Work completed 11/12/09 P.A.O. Camp

Remarks: 1" Plastic Pipe coop to curb